


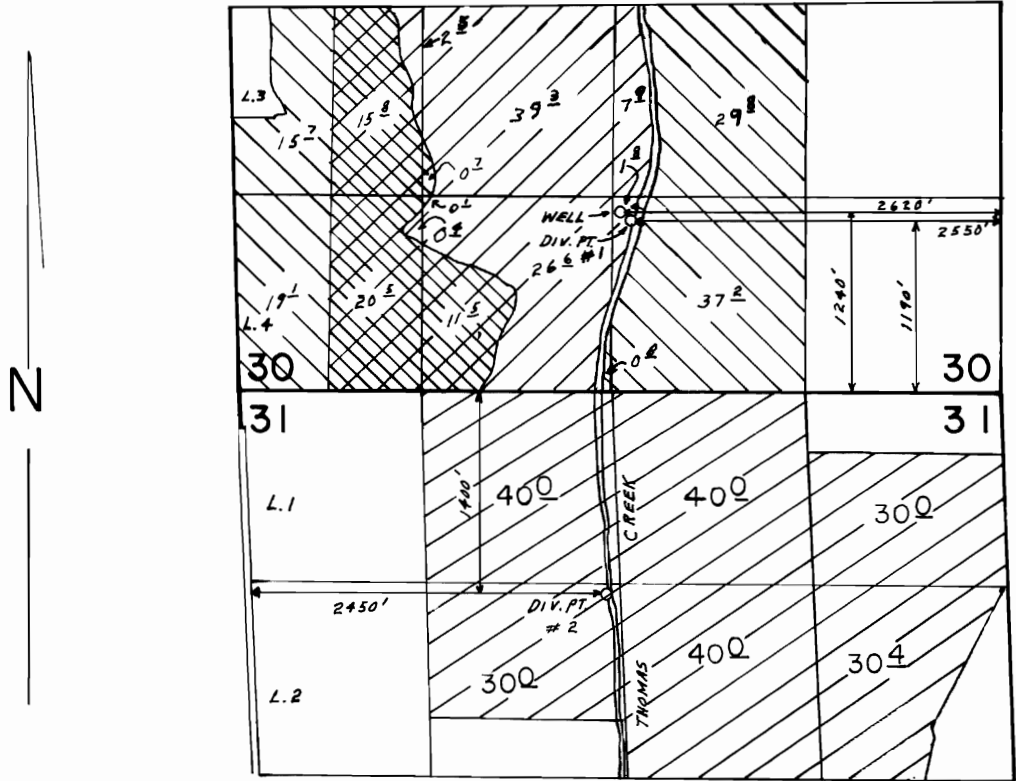


T. 38S., R. 20E., W.M.



SCALE: 1" = 1320'

-  T-4645 PRIMARY FROM DIV. NO. 1 & 2
-  G-9165 PRIMARY FROM WELL
-  G-9165 SUPPLEMENTAL FROM WELL

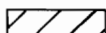FINAL PROOF SURVEY UNDER

T-4645
 Application No. G-10028 Permit No. G-9165
 IN NAME OF

GLEN BRIDGMON

Surveyed OCT. 17 1988, by B. BISHOP
OCT. 11 94 R.M. SUTTERFIELD

10/17/94
 R.M.S.
 1-24-89

L.L.C.