

4.0 ACRES OFF


4" = 1 MILE APPROX.

T-4663

RECEIVED

DEC 22 1980

WATER RESOURCES DEPT
SALEM, OREGON

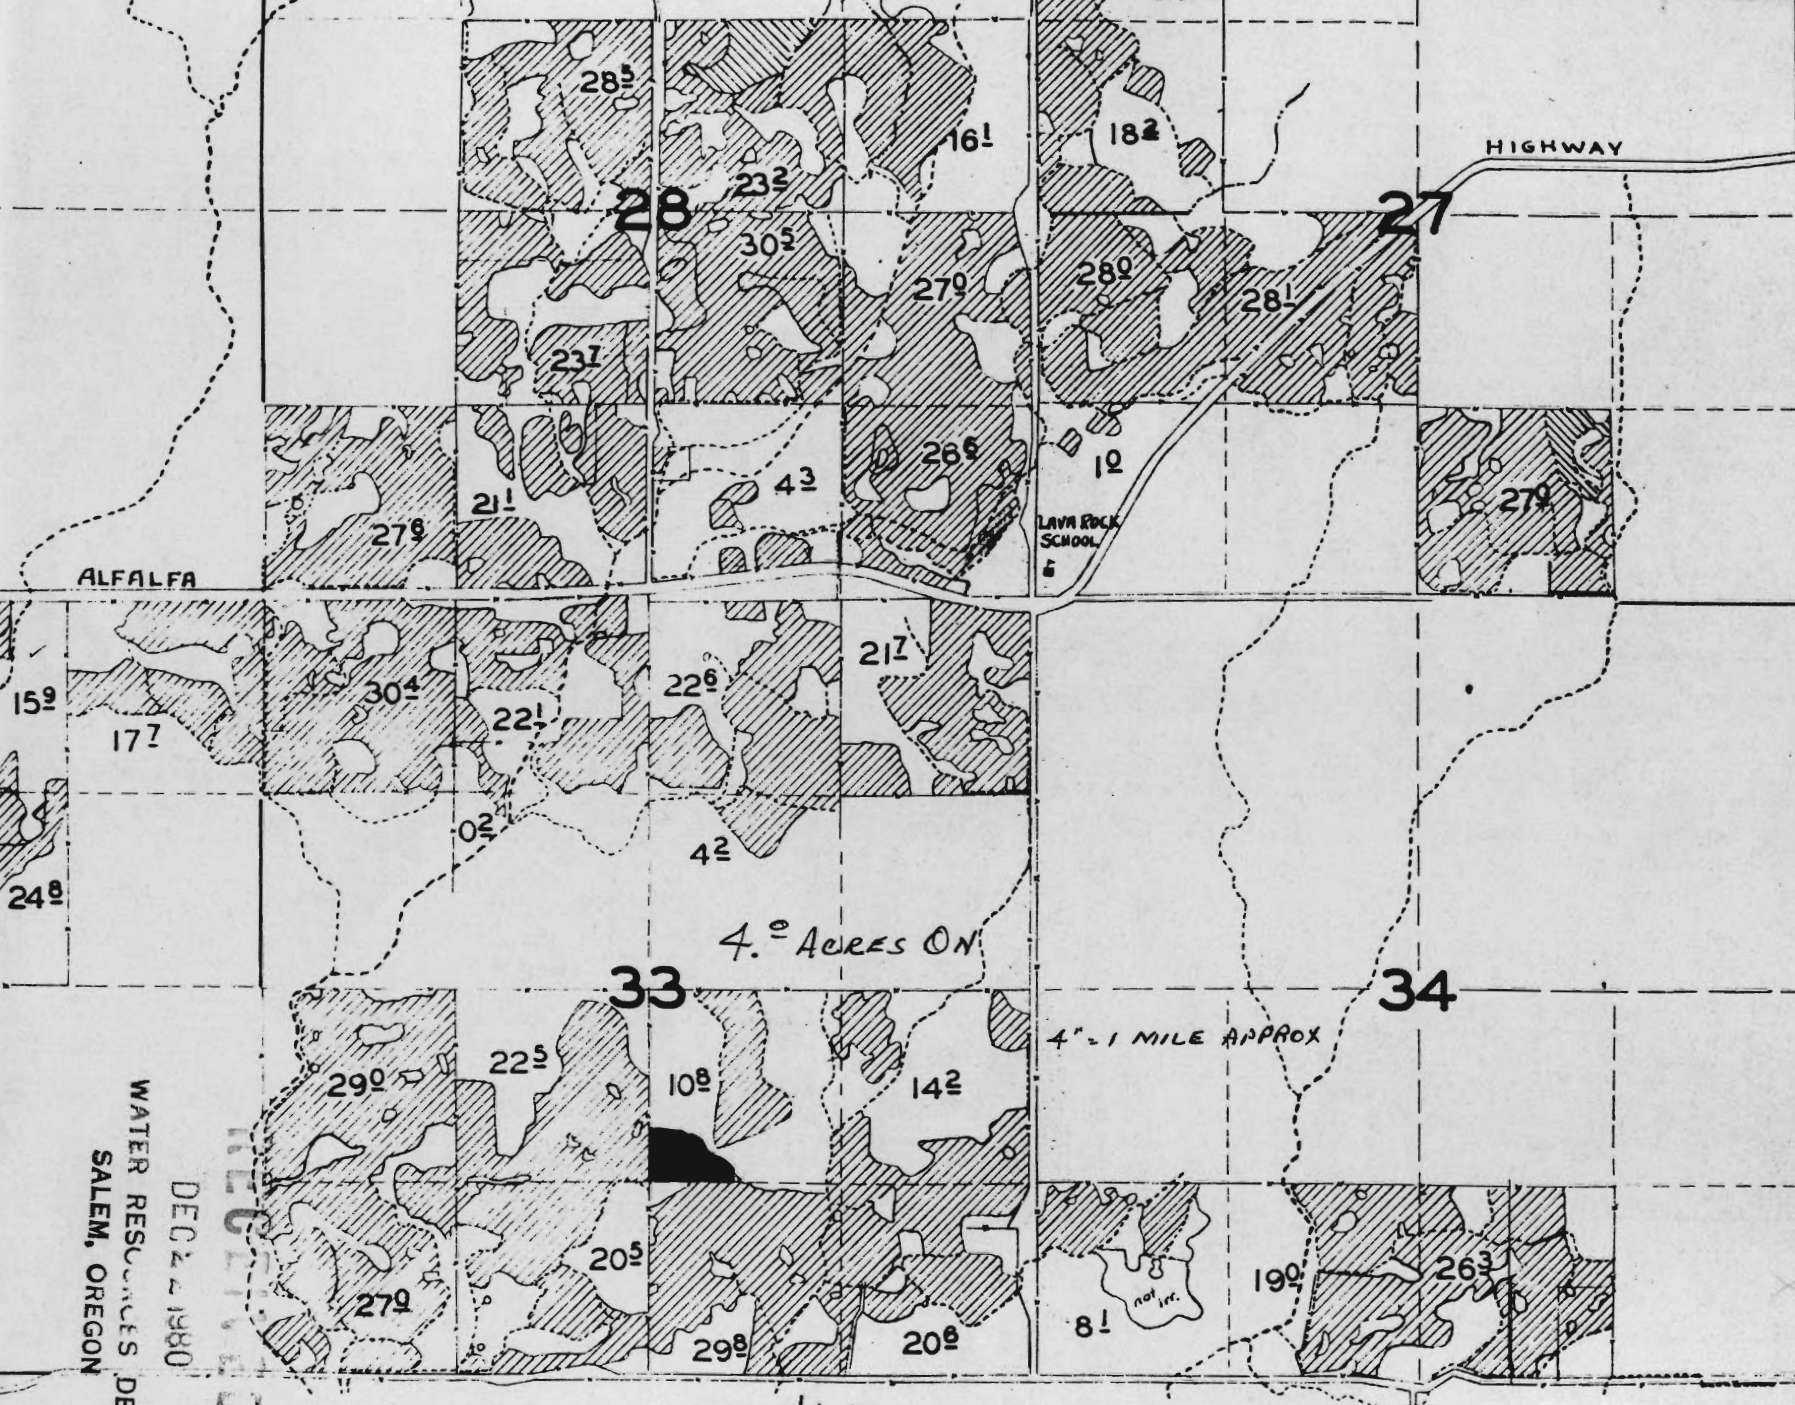

WATER RESOURCES DEPT
SALEM, OREGON

DEC 2 1980

RECEIVED

T-4663