


T.16S., R.12E., W.M.

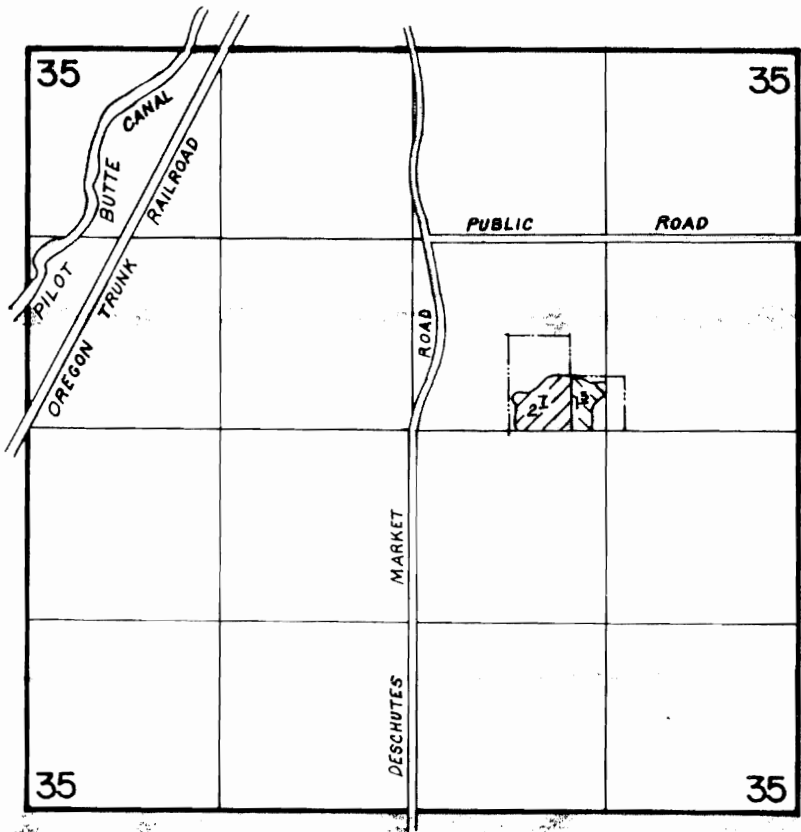

SCALE: 1" = 1320'

FINAL PROOF SURVEY

UNDER



TRANSFER NO. 4665 & 5013
Application No. Permit No.

IN NAME OF

...THEODORE A. MCKEE / C.O.I.D. ...

Surveyed JULY 31, 1984, by LESLIE OLSON.