

7-4666

BEND - ALFALFA

LAVA ROCK SCHOOL

RECEIVED
DEC 2 1980
WATER RESOURCES DEPT.
SALEM, OREGON

32

33


34


7.7 Ac. Or
4" = 1 MILE, APPROX.

RECEIVED

AUG 12 1982

WATER RESOURCES DEPT.
SALEM, OREGON

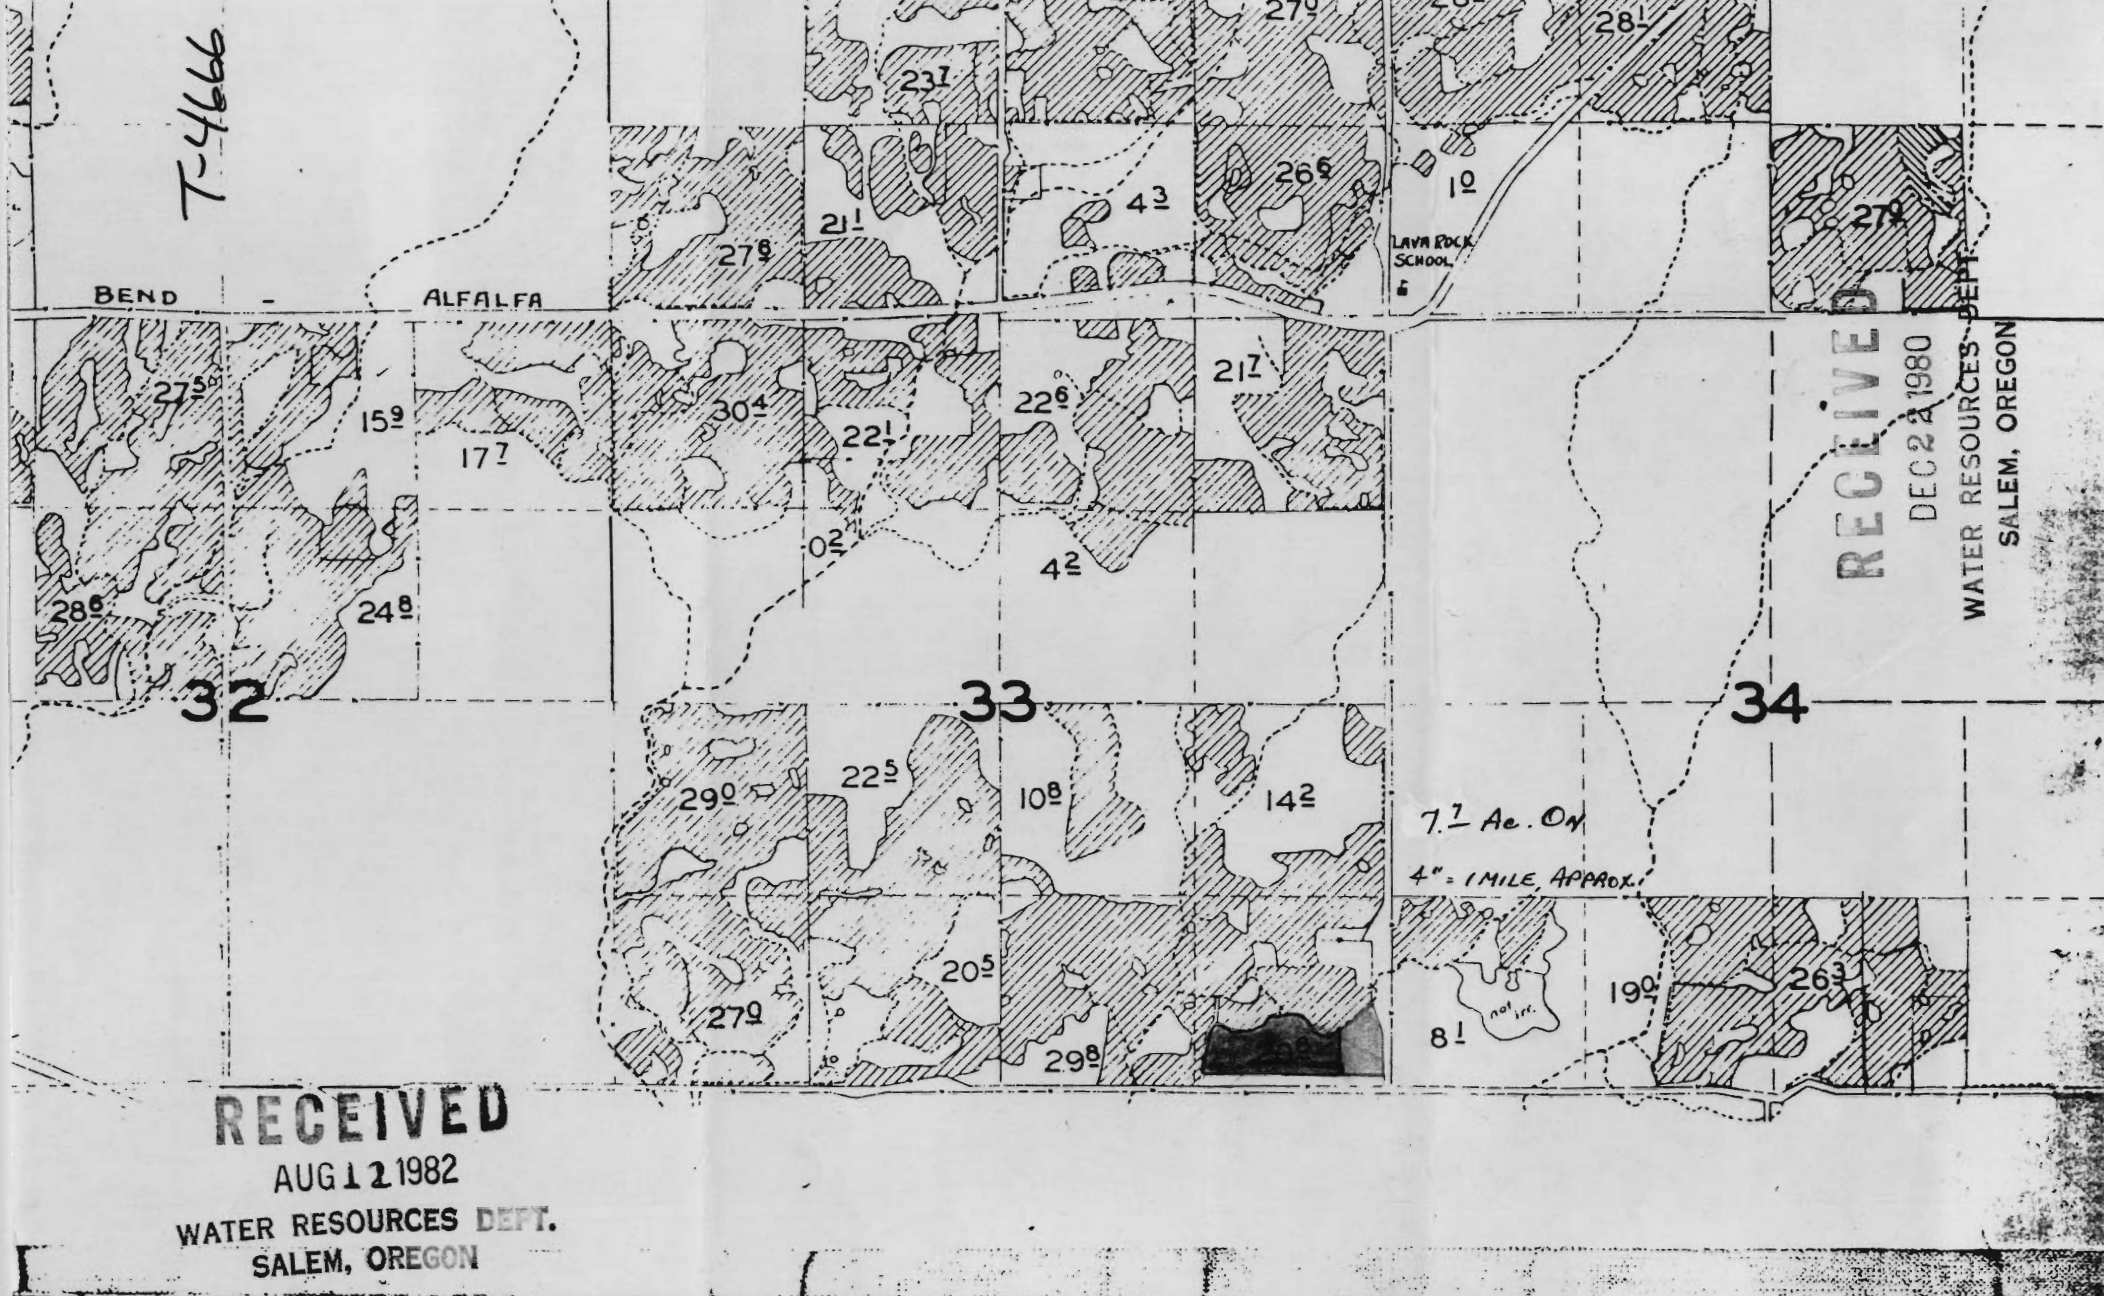

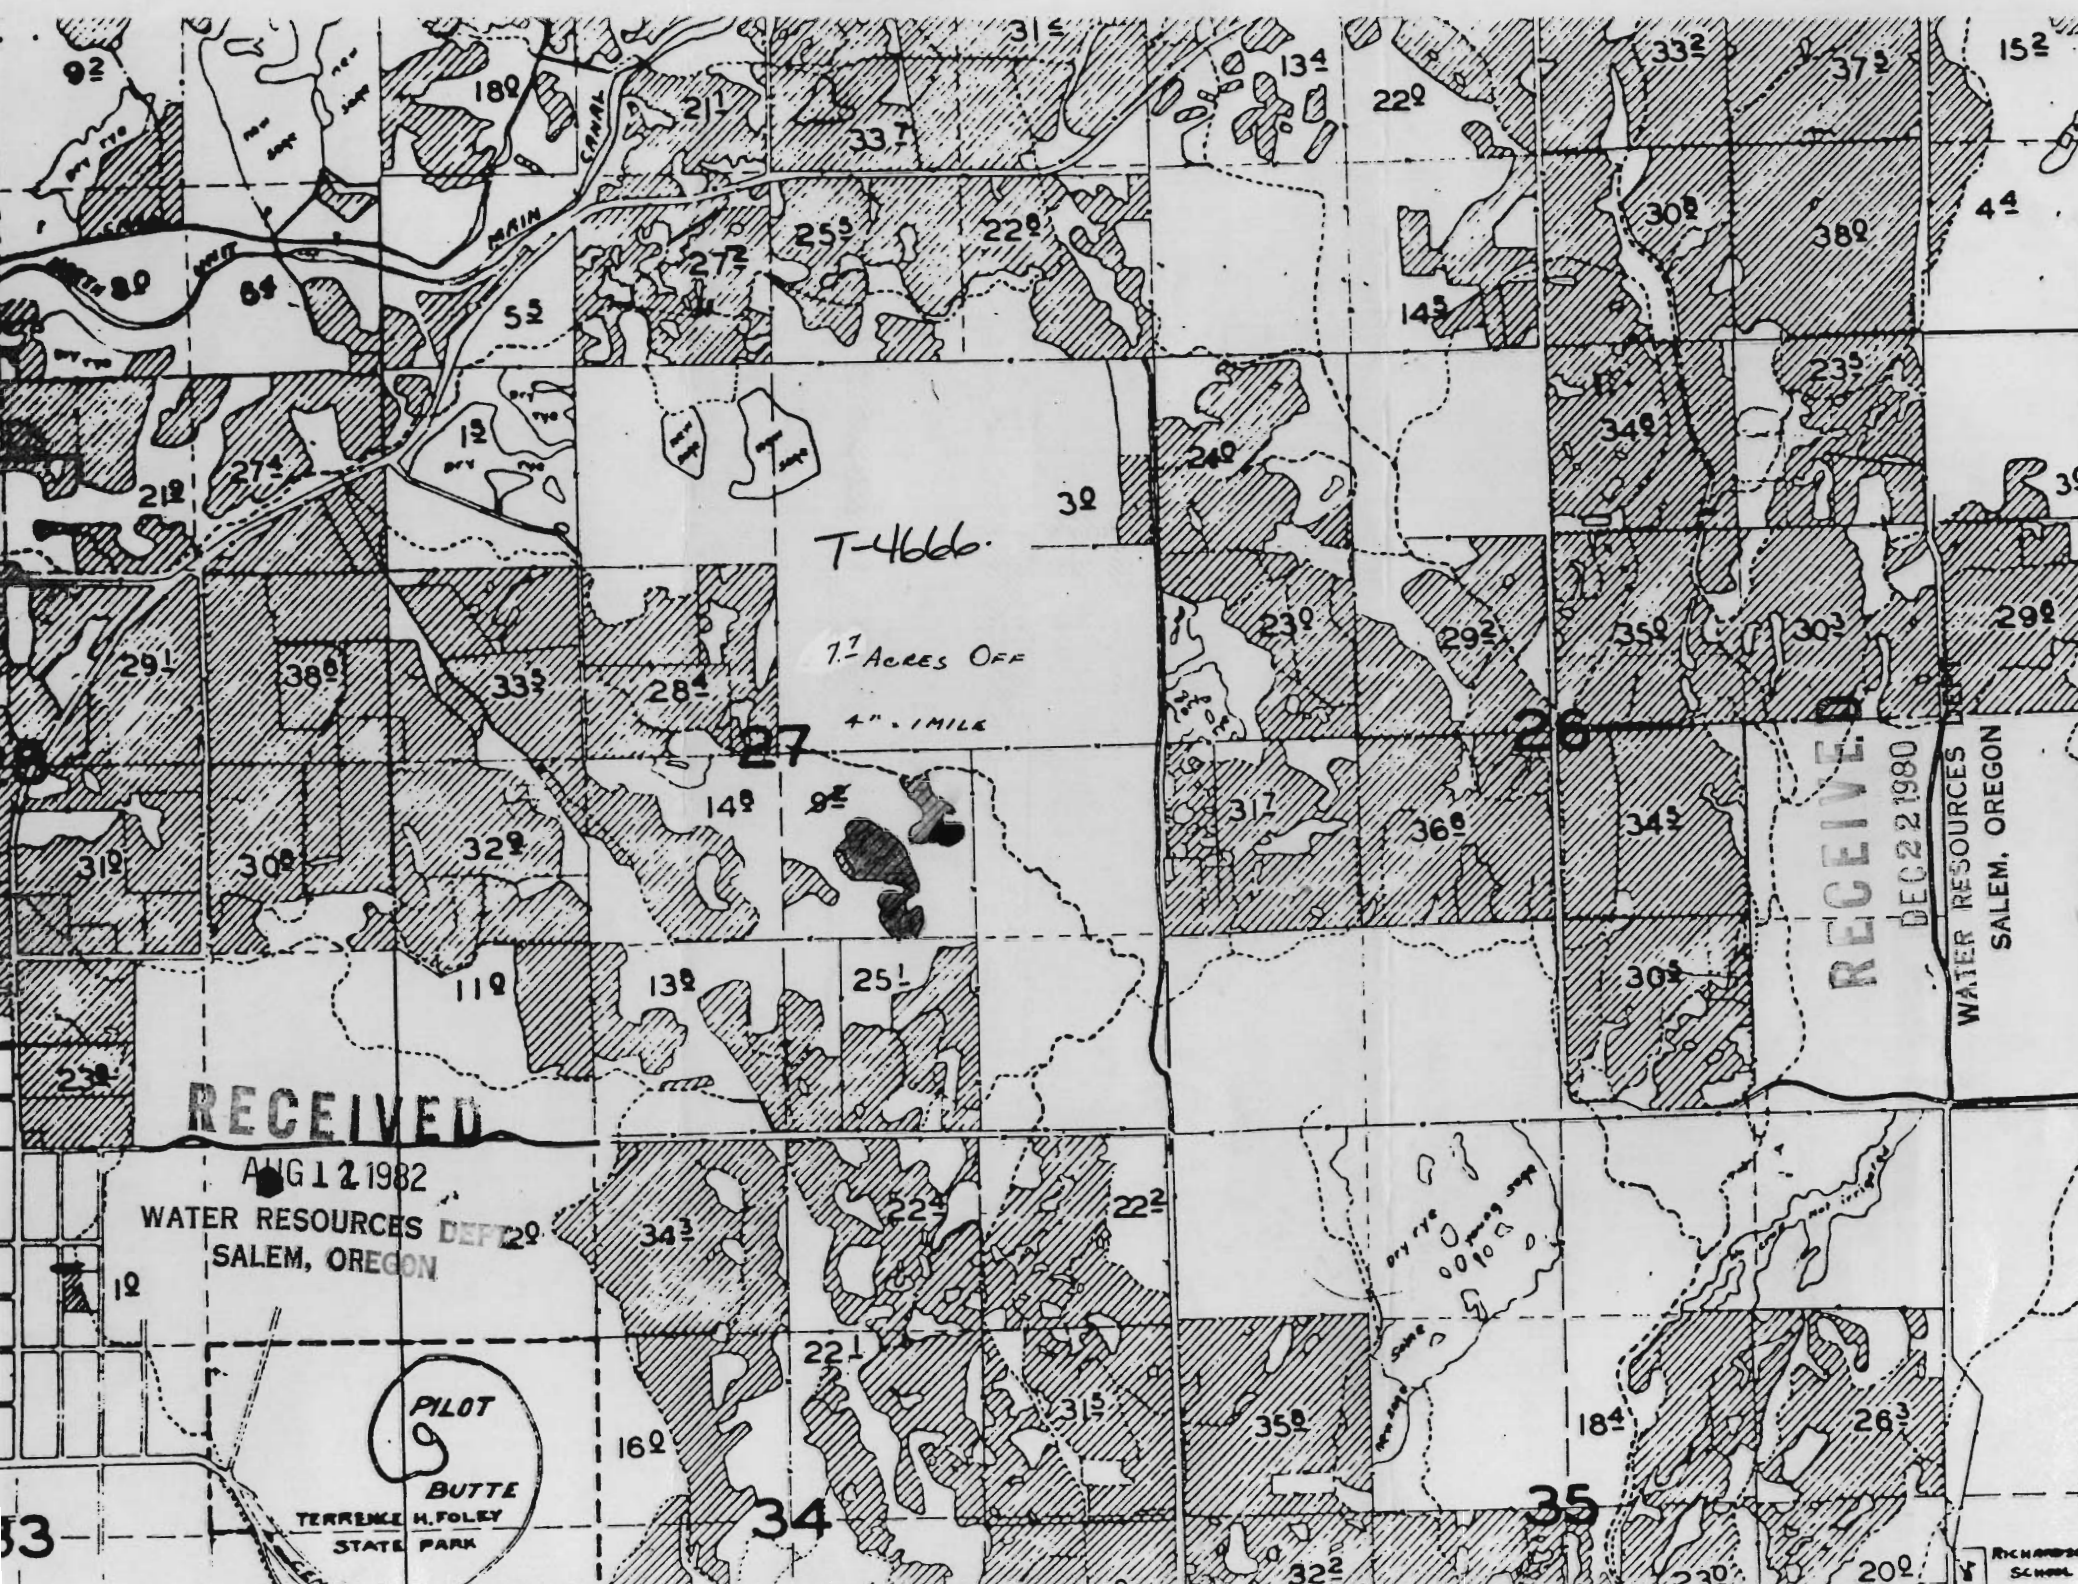

T-4666

7.7 ACRES OFF

4" = 1 MILE

RECEIVED

DEC 22 1980

WATER RESOURCES DEPT
SALEM, OREGON

RECEIVED

AUG 12 1982

WATER RESOURCES DEPT
SALEM, OREGON

PILOT
9
BUTTE
TERRENCE H. FOLEY
STATE PARK

RICHARDSON
SCHOOL