


T. 39 S., R. 7 W., W. M.

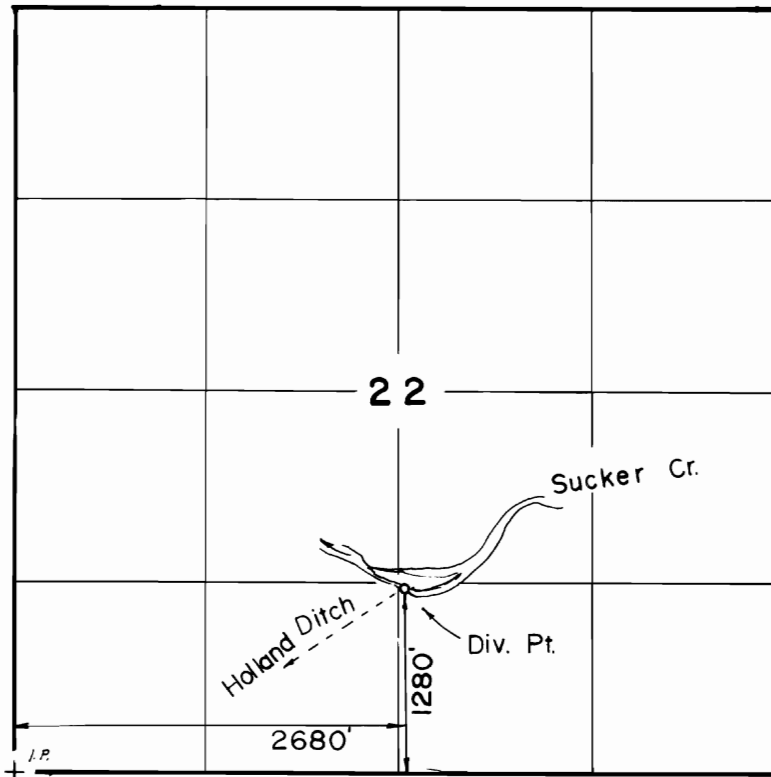

Scale: 1" = 1320'

FINAL PROOF SURVEY
UNDER

TRANSFER NO. 4667

Application No. Permit No.
IN NAME OF

..... DEAN S. MAYFIELD

Surveyed MAY 12, 1986, by B. S. JAMES.