


T.6S., R.39E., W.M.

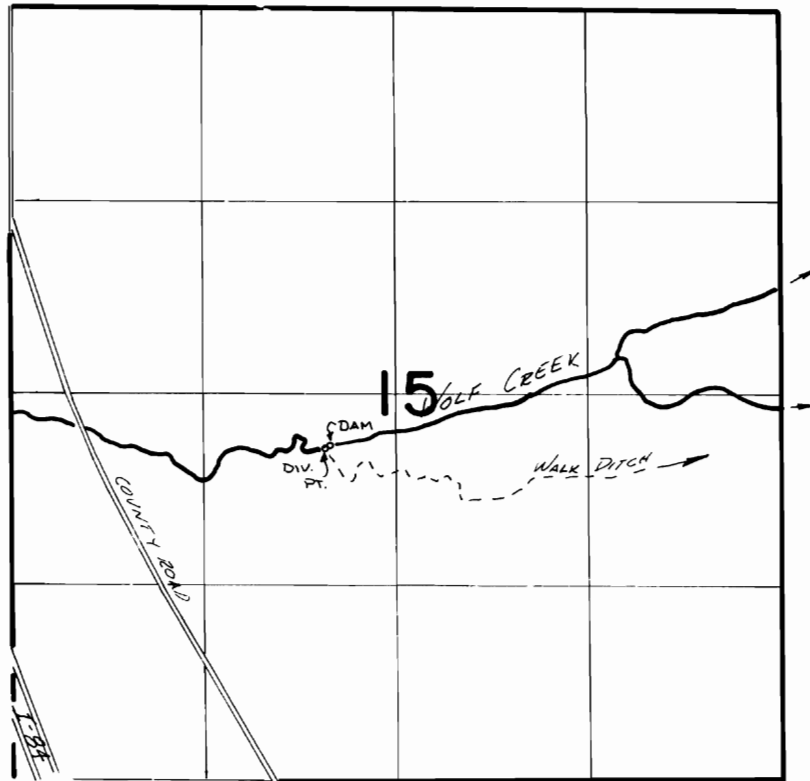

Div. Pt. Loc: 370' S. & 490' W. FROM CENTER COR. SEC 15

**FINAL PROOF SURVEY**  
UNDER

**TRANSFER 4669**

IN NAME OF

.....DON.....DODSON.....

Surveyed Nov. 20, 1931, by V. L. Church.....