


# T. 4 S. R. 2 W. W. M.

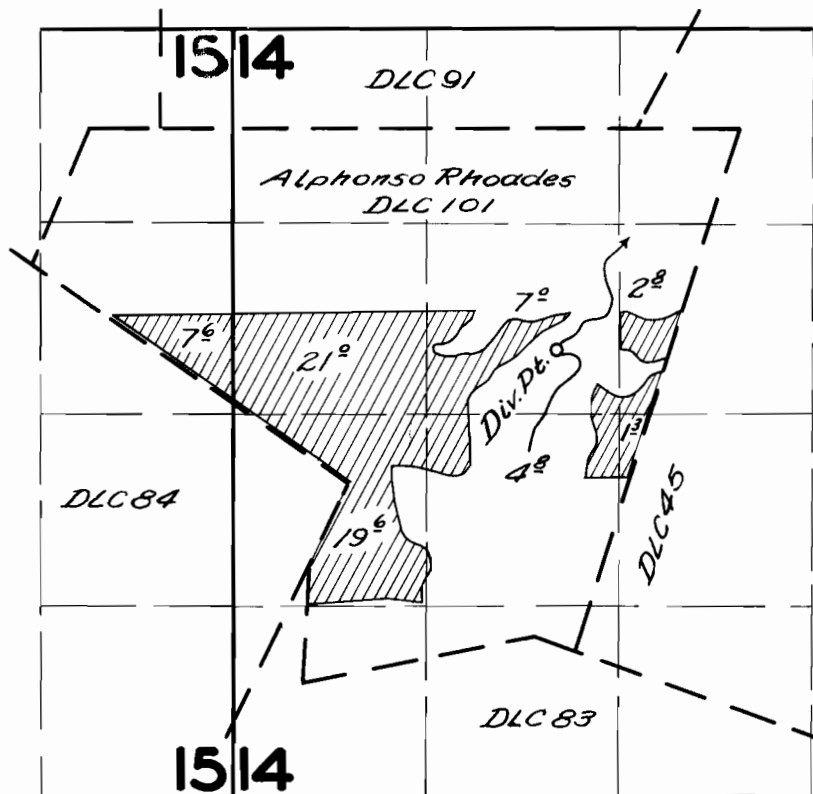

## FINAL PROOF SURVEY UNDER

Application No. 26641 ... Permit No. 20868 ...  
IN NAME OF

*Frank J. Pokorny*

Surveyed *June 9* 1958, by *C. O. Bartala*...