


T. 6N., R. 35E., W. M.

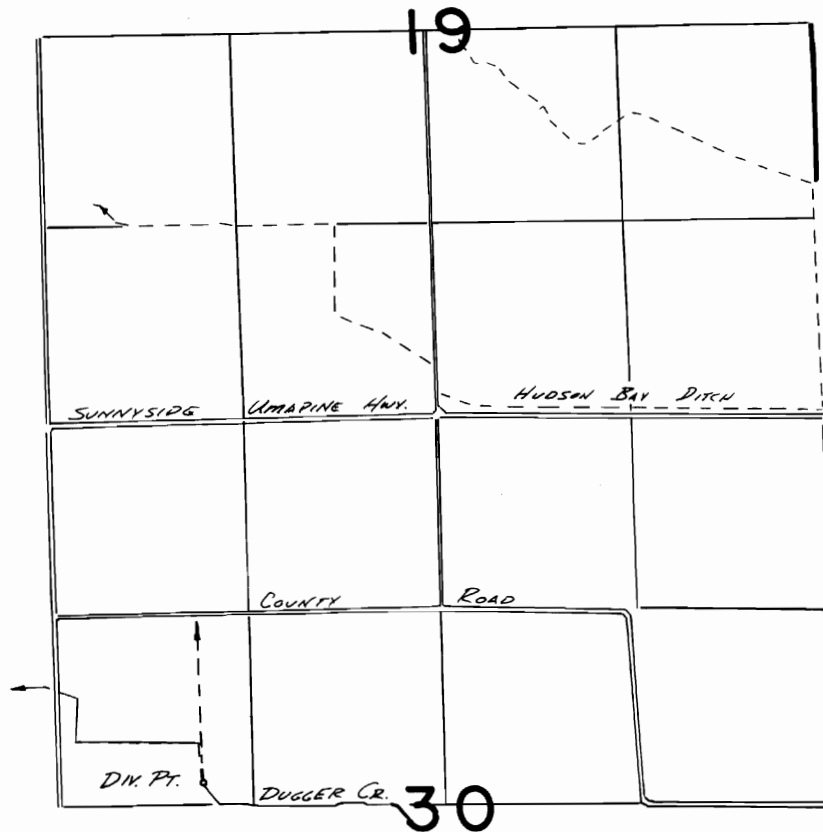

DIV. PT. LOC: 150' N. & 1000' E. FROM W¹/₄ COR. SEC. 30

FINAL PROOF SURVEY
UNDER

TRANSFER 4673

IN NAME OF

HOWARD PALMER

Surveyed Aug. 31, 1982, by V. L. CHURCH...