

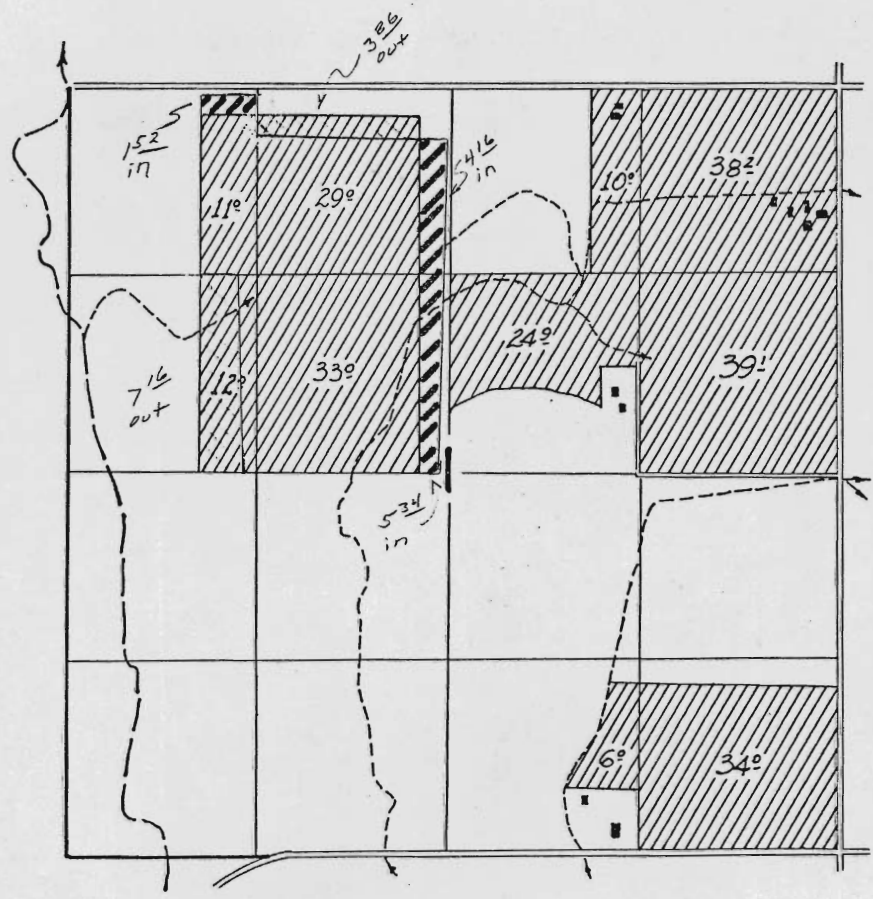
T-4680

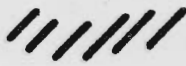

RECEIVED

JAN 22 1981

WATER RESOURCES DEPT
SALEM, OREGON

T 40 S, R 18 E, W.M.



 Transfer in
 Transfer out