


T. 2N., R. 27E., W. M.

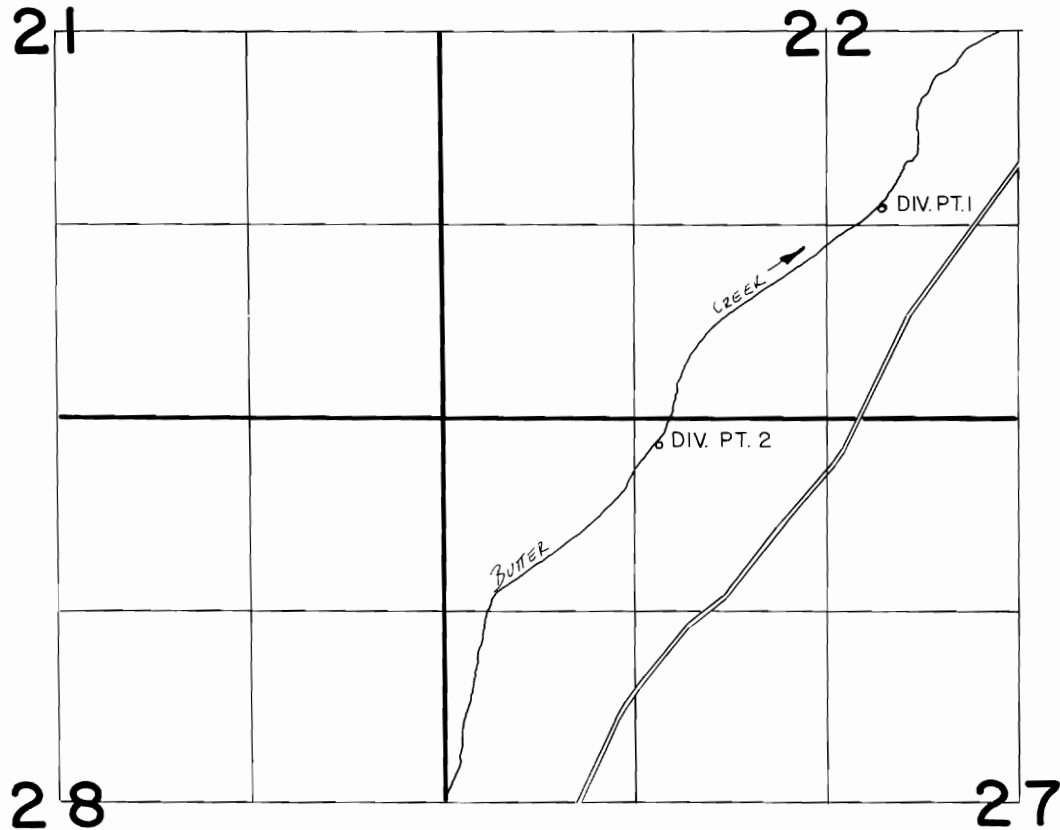

DIV. PT. 1 LOC. 1450'N. & 360'E. FROM N1/4 COR. SEC. 27
DIV. PT. 2 LOC. 180'S. & 1140'W. FROM N1/4 COR. SEC. 27

FINAL PROOF SURVEY
UNDER

TRANSFER 4681
IN NAME OF

.....**JOHN E. CORREA**.....

Surveyed 11-7-1985, by V.L. CHURCH.....

SCALE 1"=1320'