


T. 3N., R. 26E., W. M.

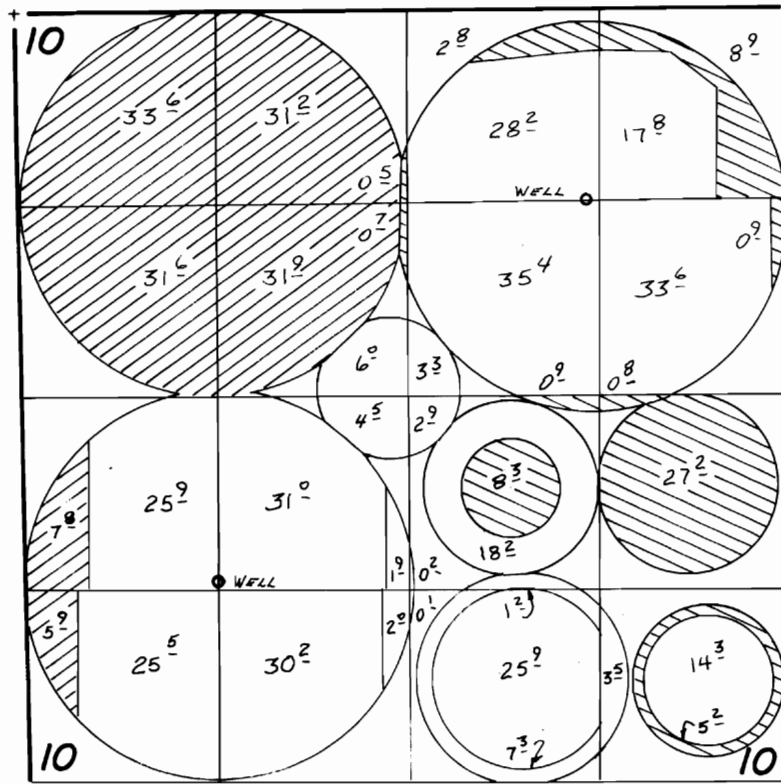

T-4686



T-4687

FINAL PROOF SURVEY UNDER

TRANSFER 4686,4687

Application No. Permit No.
IN NAME OF

..... **JERRY BREWER**

Surveyed 12-13..... 1983., by V.L. Church.....