


# T. 36 S., R. 3 W., W.M.

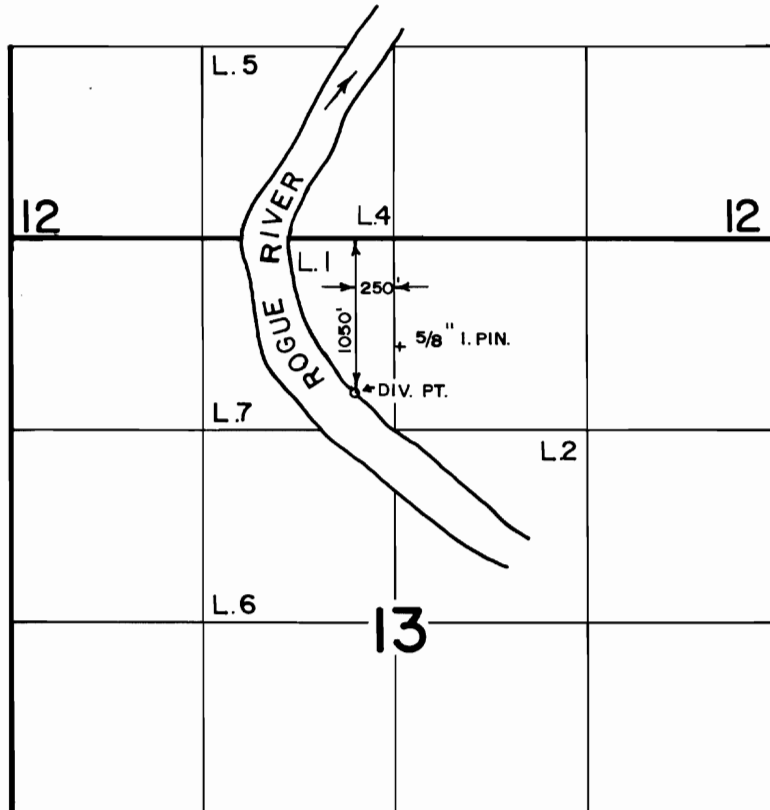

## FINAL PROOF SURVEY UNDER

Transfer No. 4693

Application No. .... Permit No. ....  
IN NAME OF

**GEORGE B. & or SYLVIA O. BERENSON**

Surveyed FEB. 4, 1983, by B.S. JAMES.....

SCALE: 4" = 1 Mile