



FEB 17 1981

RECEIVED

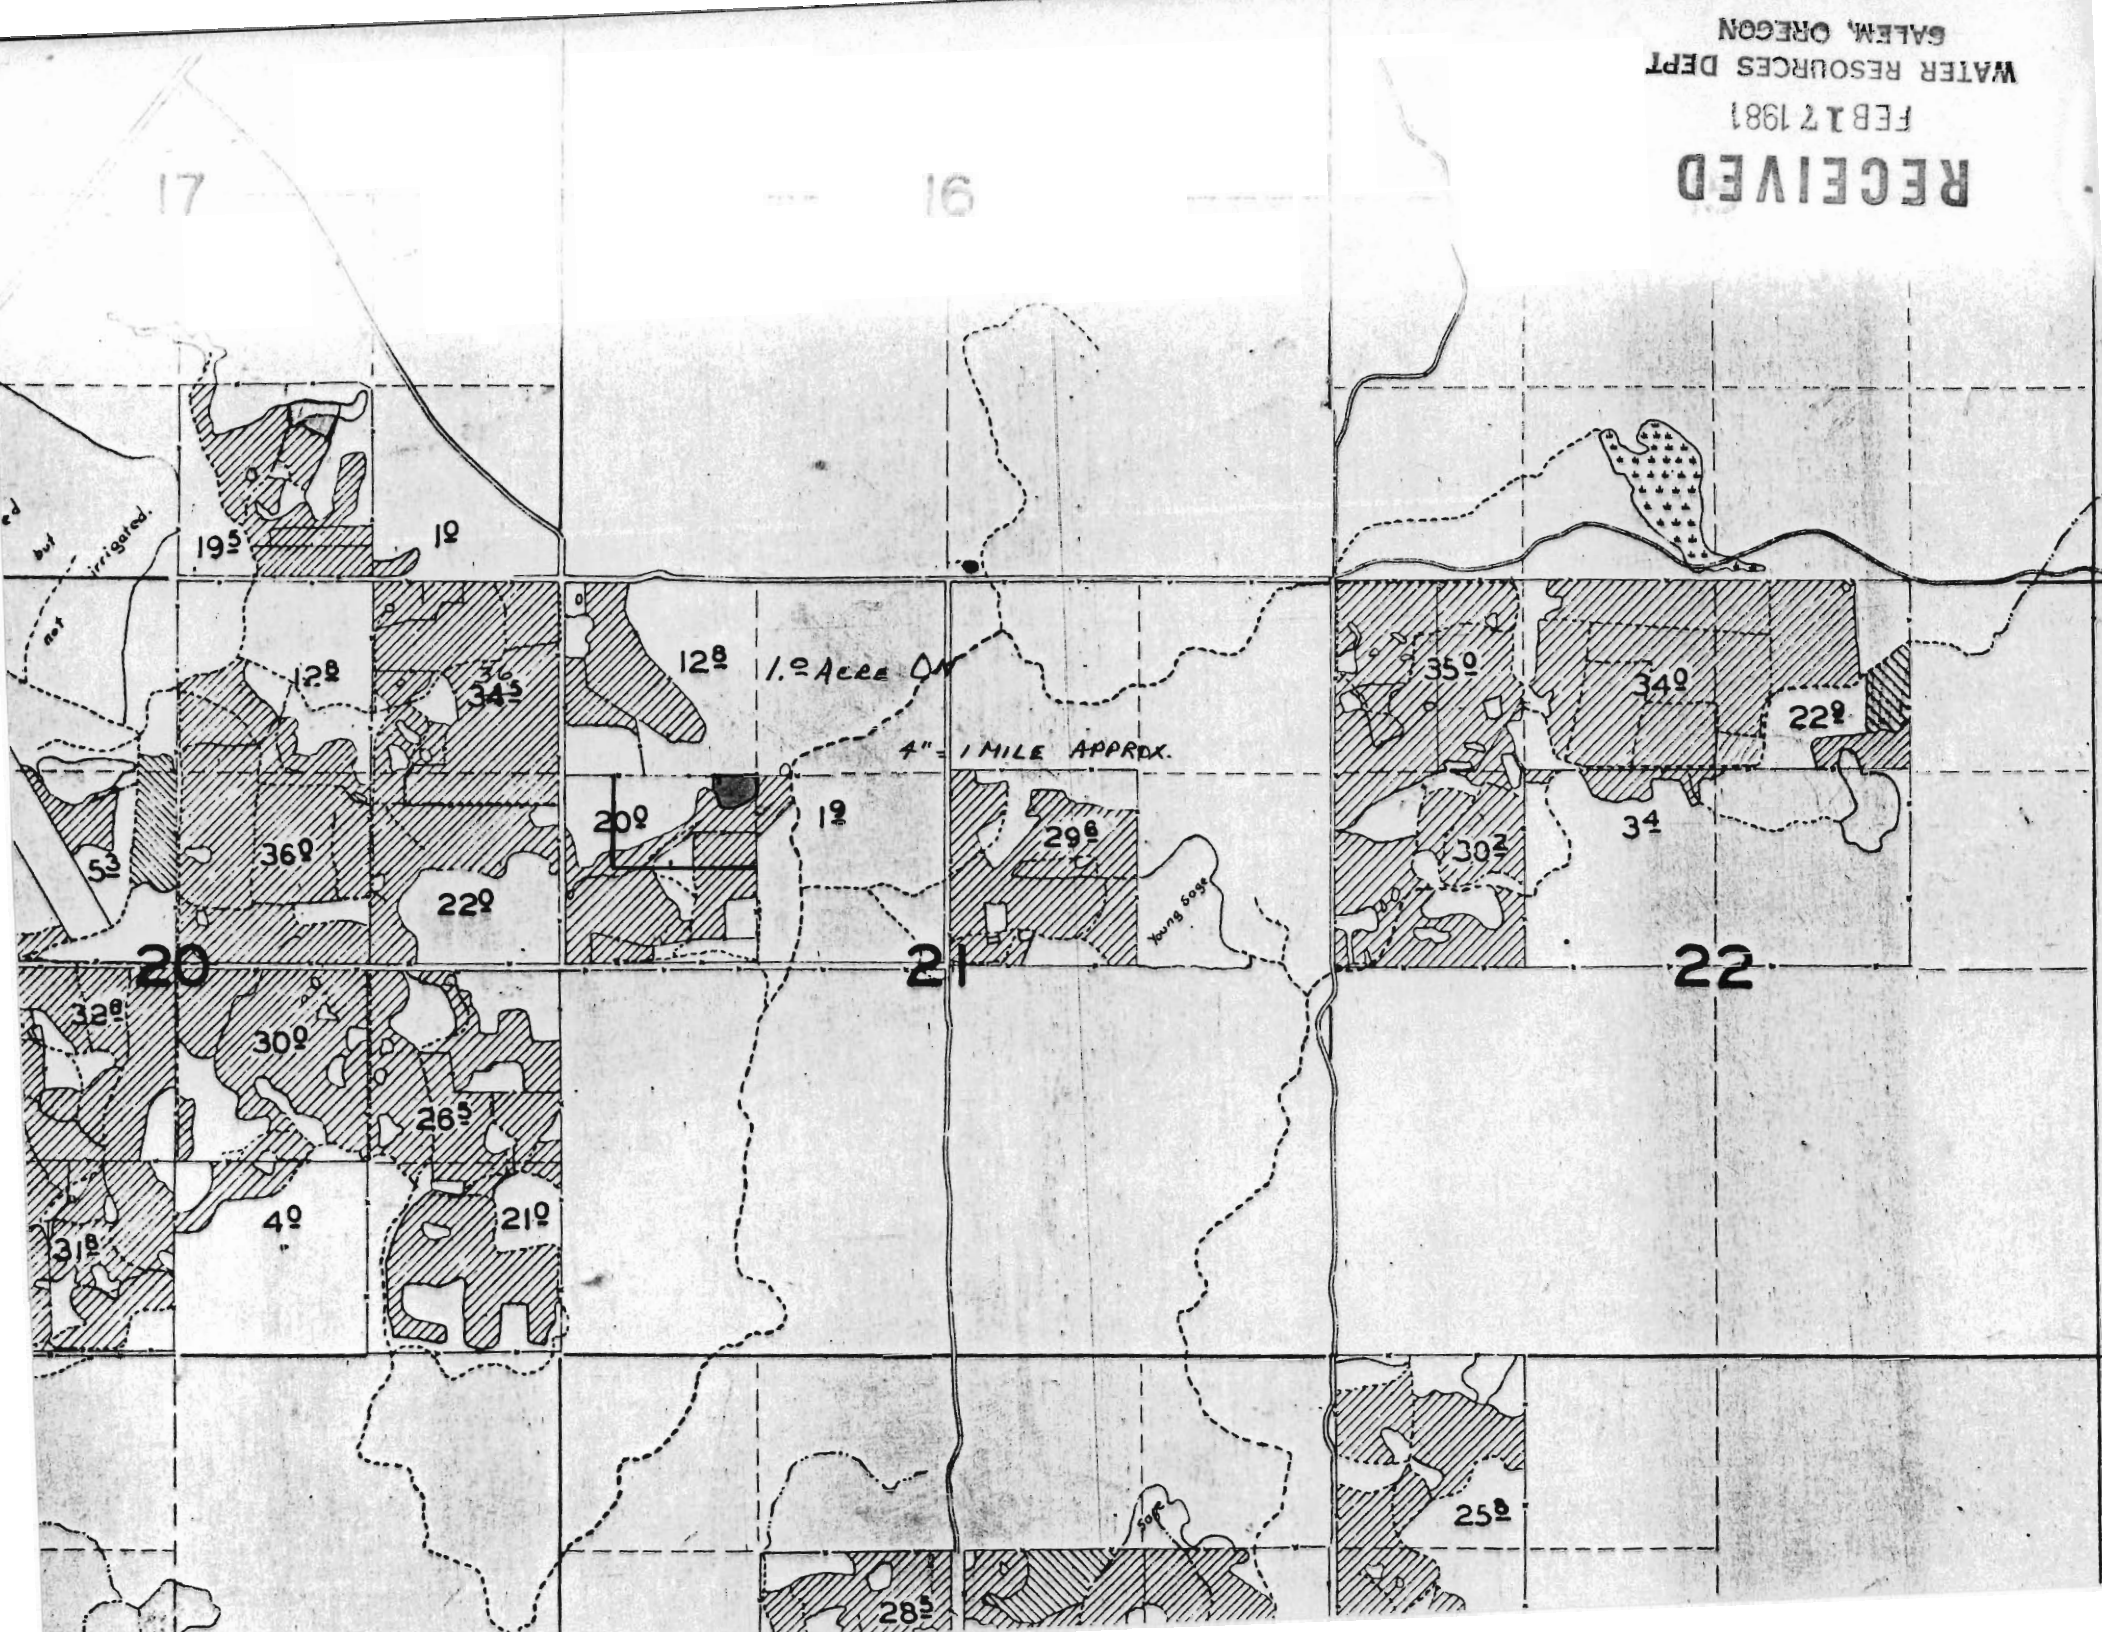

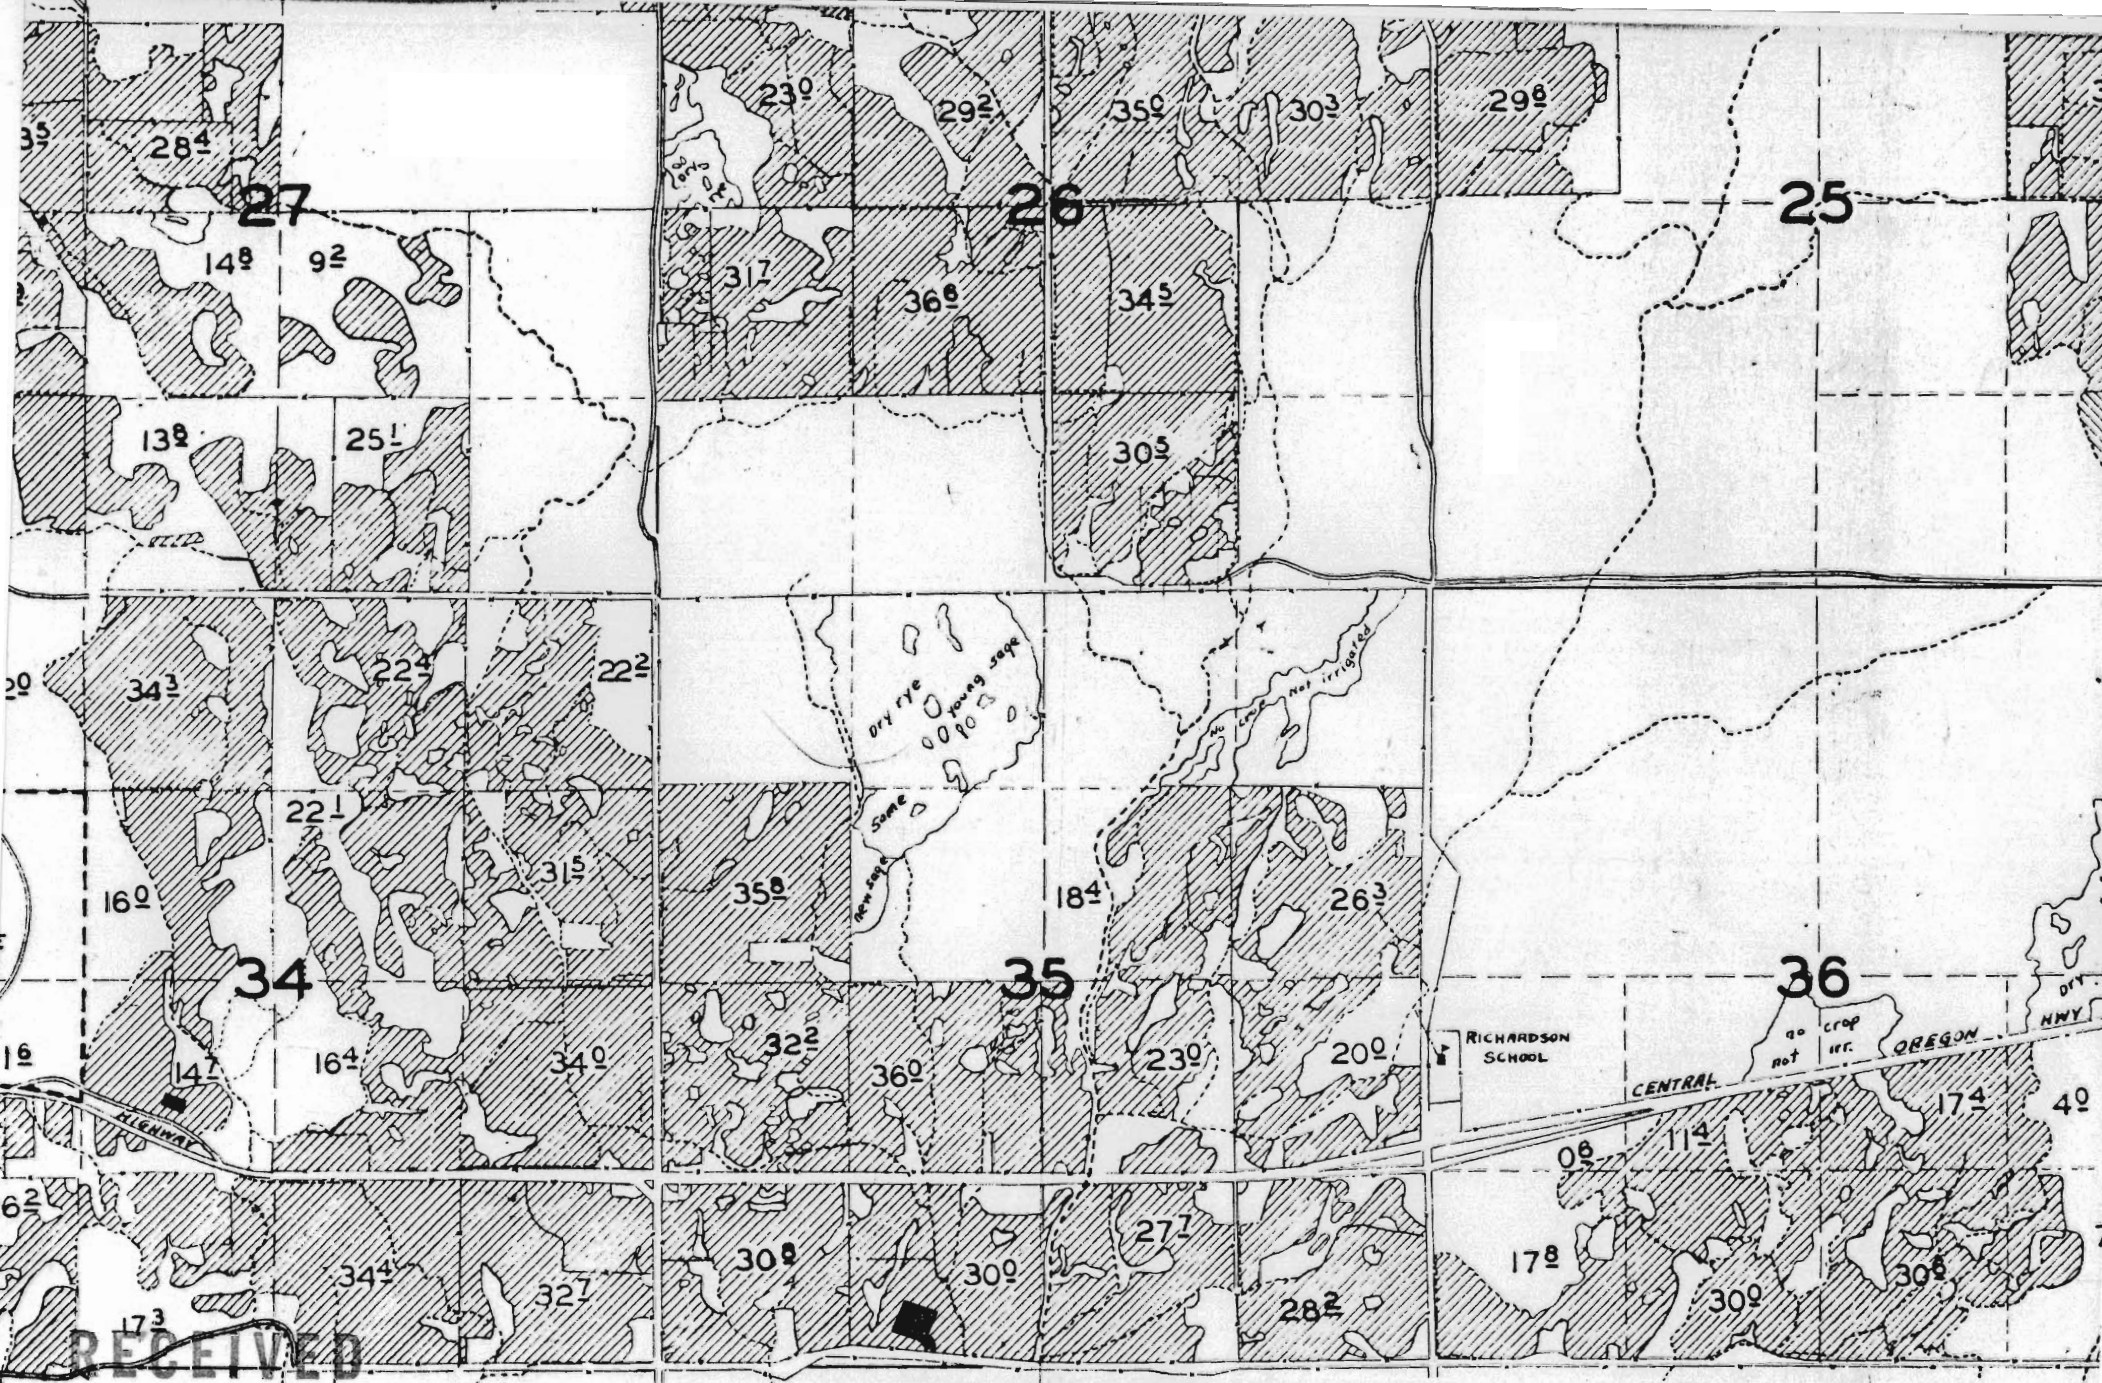

RECEIVED

FEB 17 1981

WATER RESOURCES DEPT
SALEM, OREGON

1.0 ACRE OFF
4" = 1 MILE APPROX.