


RECEIVED

MAR 10 1981  
WATER RESOURCES DEPT.  
SALEM, OREGON

J-4703

3+2  
T14S R16E

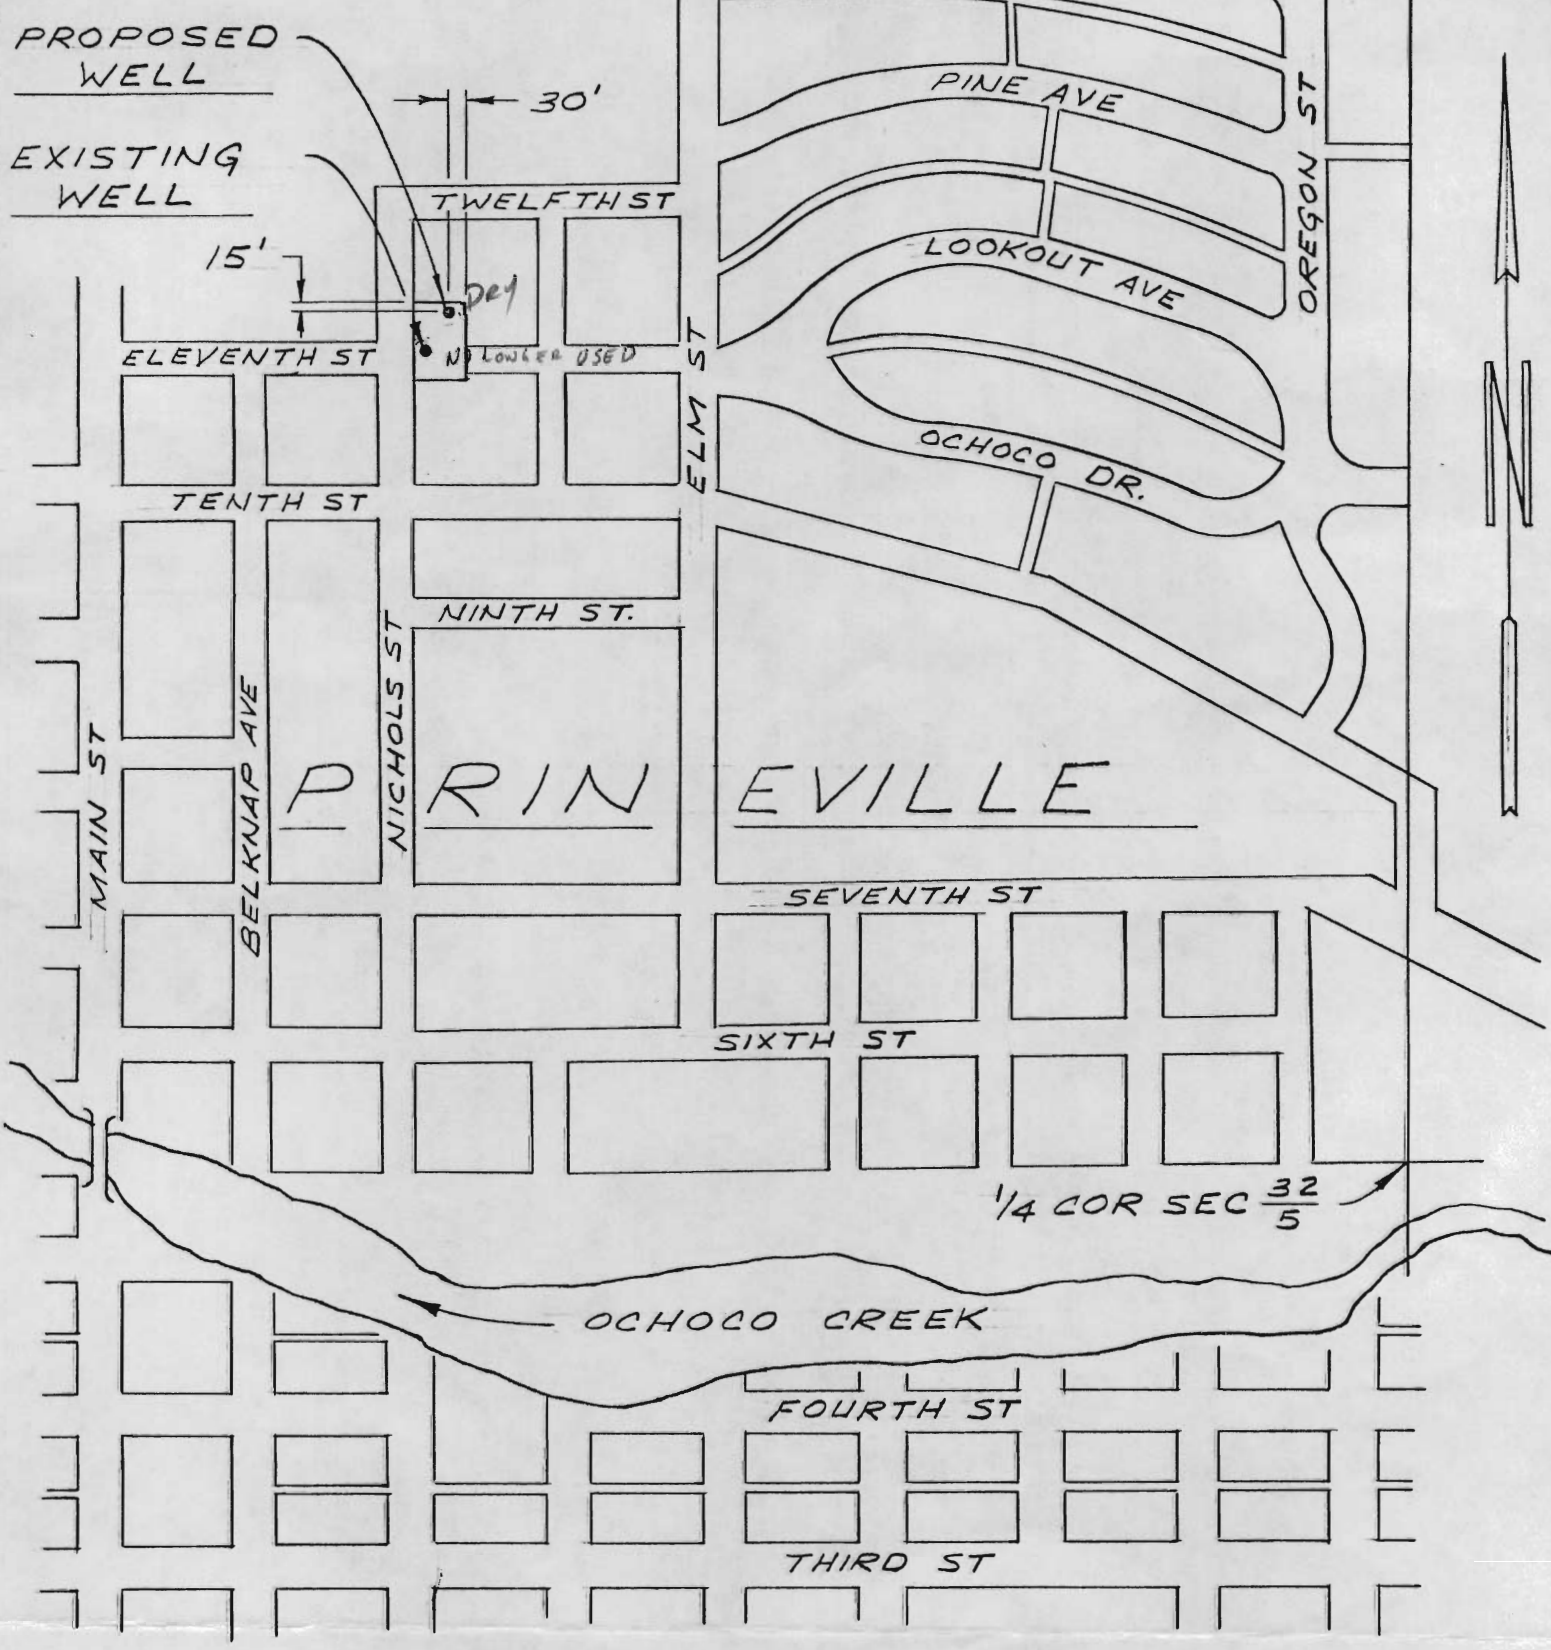

PRINEVILLE, OREGON  
 WATER DISTRIBUTION SYSTEM  
 MAP TO ACCOMPANY AN APPLICATION  
 FOR OCHOCO HEIGHTS WELL No. 2  
 PACIFIC POWER & LIGHT  
 PORTLAND, OREGON  
 SCALE: 1" = 400' FEB. 1981