


T. 4S., R. 12 & 13E., W. M.

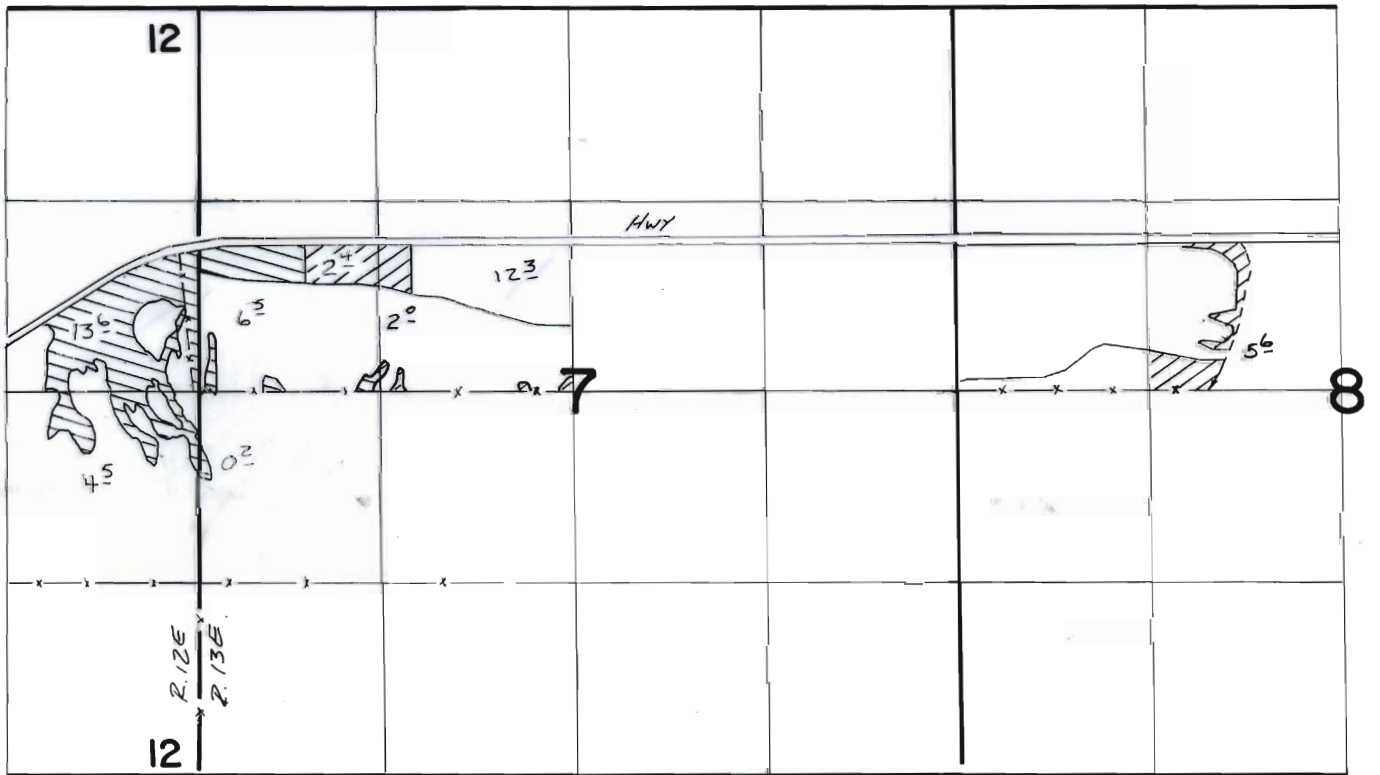

T-4704



T-4957

**FINAL PROOF SURVEY**  
 UNDER

**TRANSFERS 4704, 4957**  
 IN NAME OF

**Wm. R. McALLISTER**

Surveyed 10-19 1988, by Vb. Church



SCALE 1" = 1320