



T.17S., R.14E., W.M.

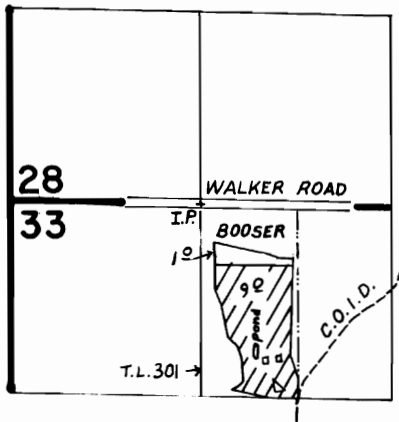

T.18S., R.13E., W.M.

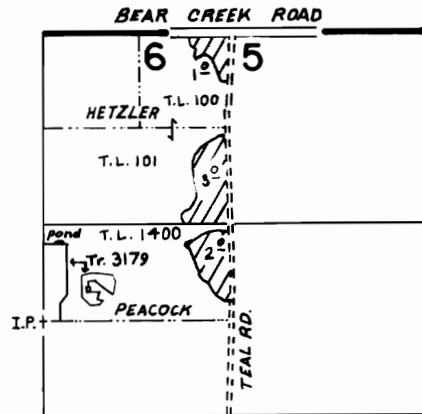

SCALE: 1" = 1320'

FINAL PROOF SURVEY UNDER

TRANSFER NO. 4712

IN NAME OF

.....C.O.I.D./owners shown above.....

Surveyed SEPT. 17, 1984, by LESLIE OLSON,
and APRIL 29, 1986