


T.16S.R.23E.W.M.

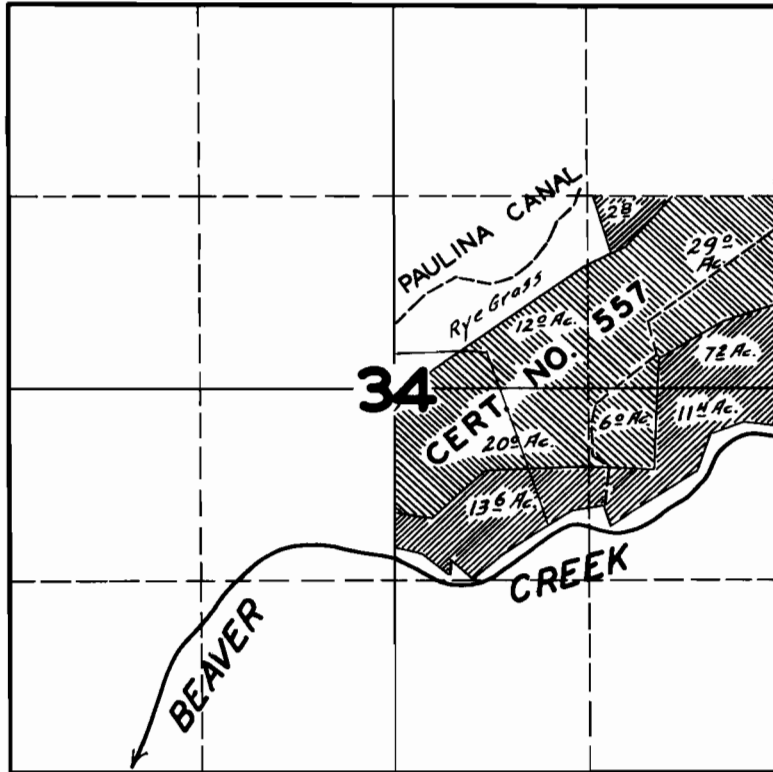

FINAL PROOF SURVEY
UNDER

Application No. 14814 Permit No. 10848

IN NAME OF
DORA GLEE CONGLETON

Surveyed MAY 1 1946, by [Signature]