


T-4204

RECEIVED
AUG 6 1981
WATER RESOURCES DEPT
SALEM, OREGON

SECTION 12 T.16 S. R.11 E. W.M.

1" = 400'

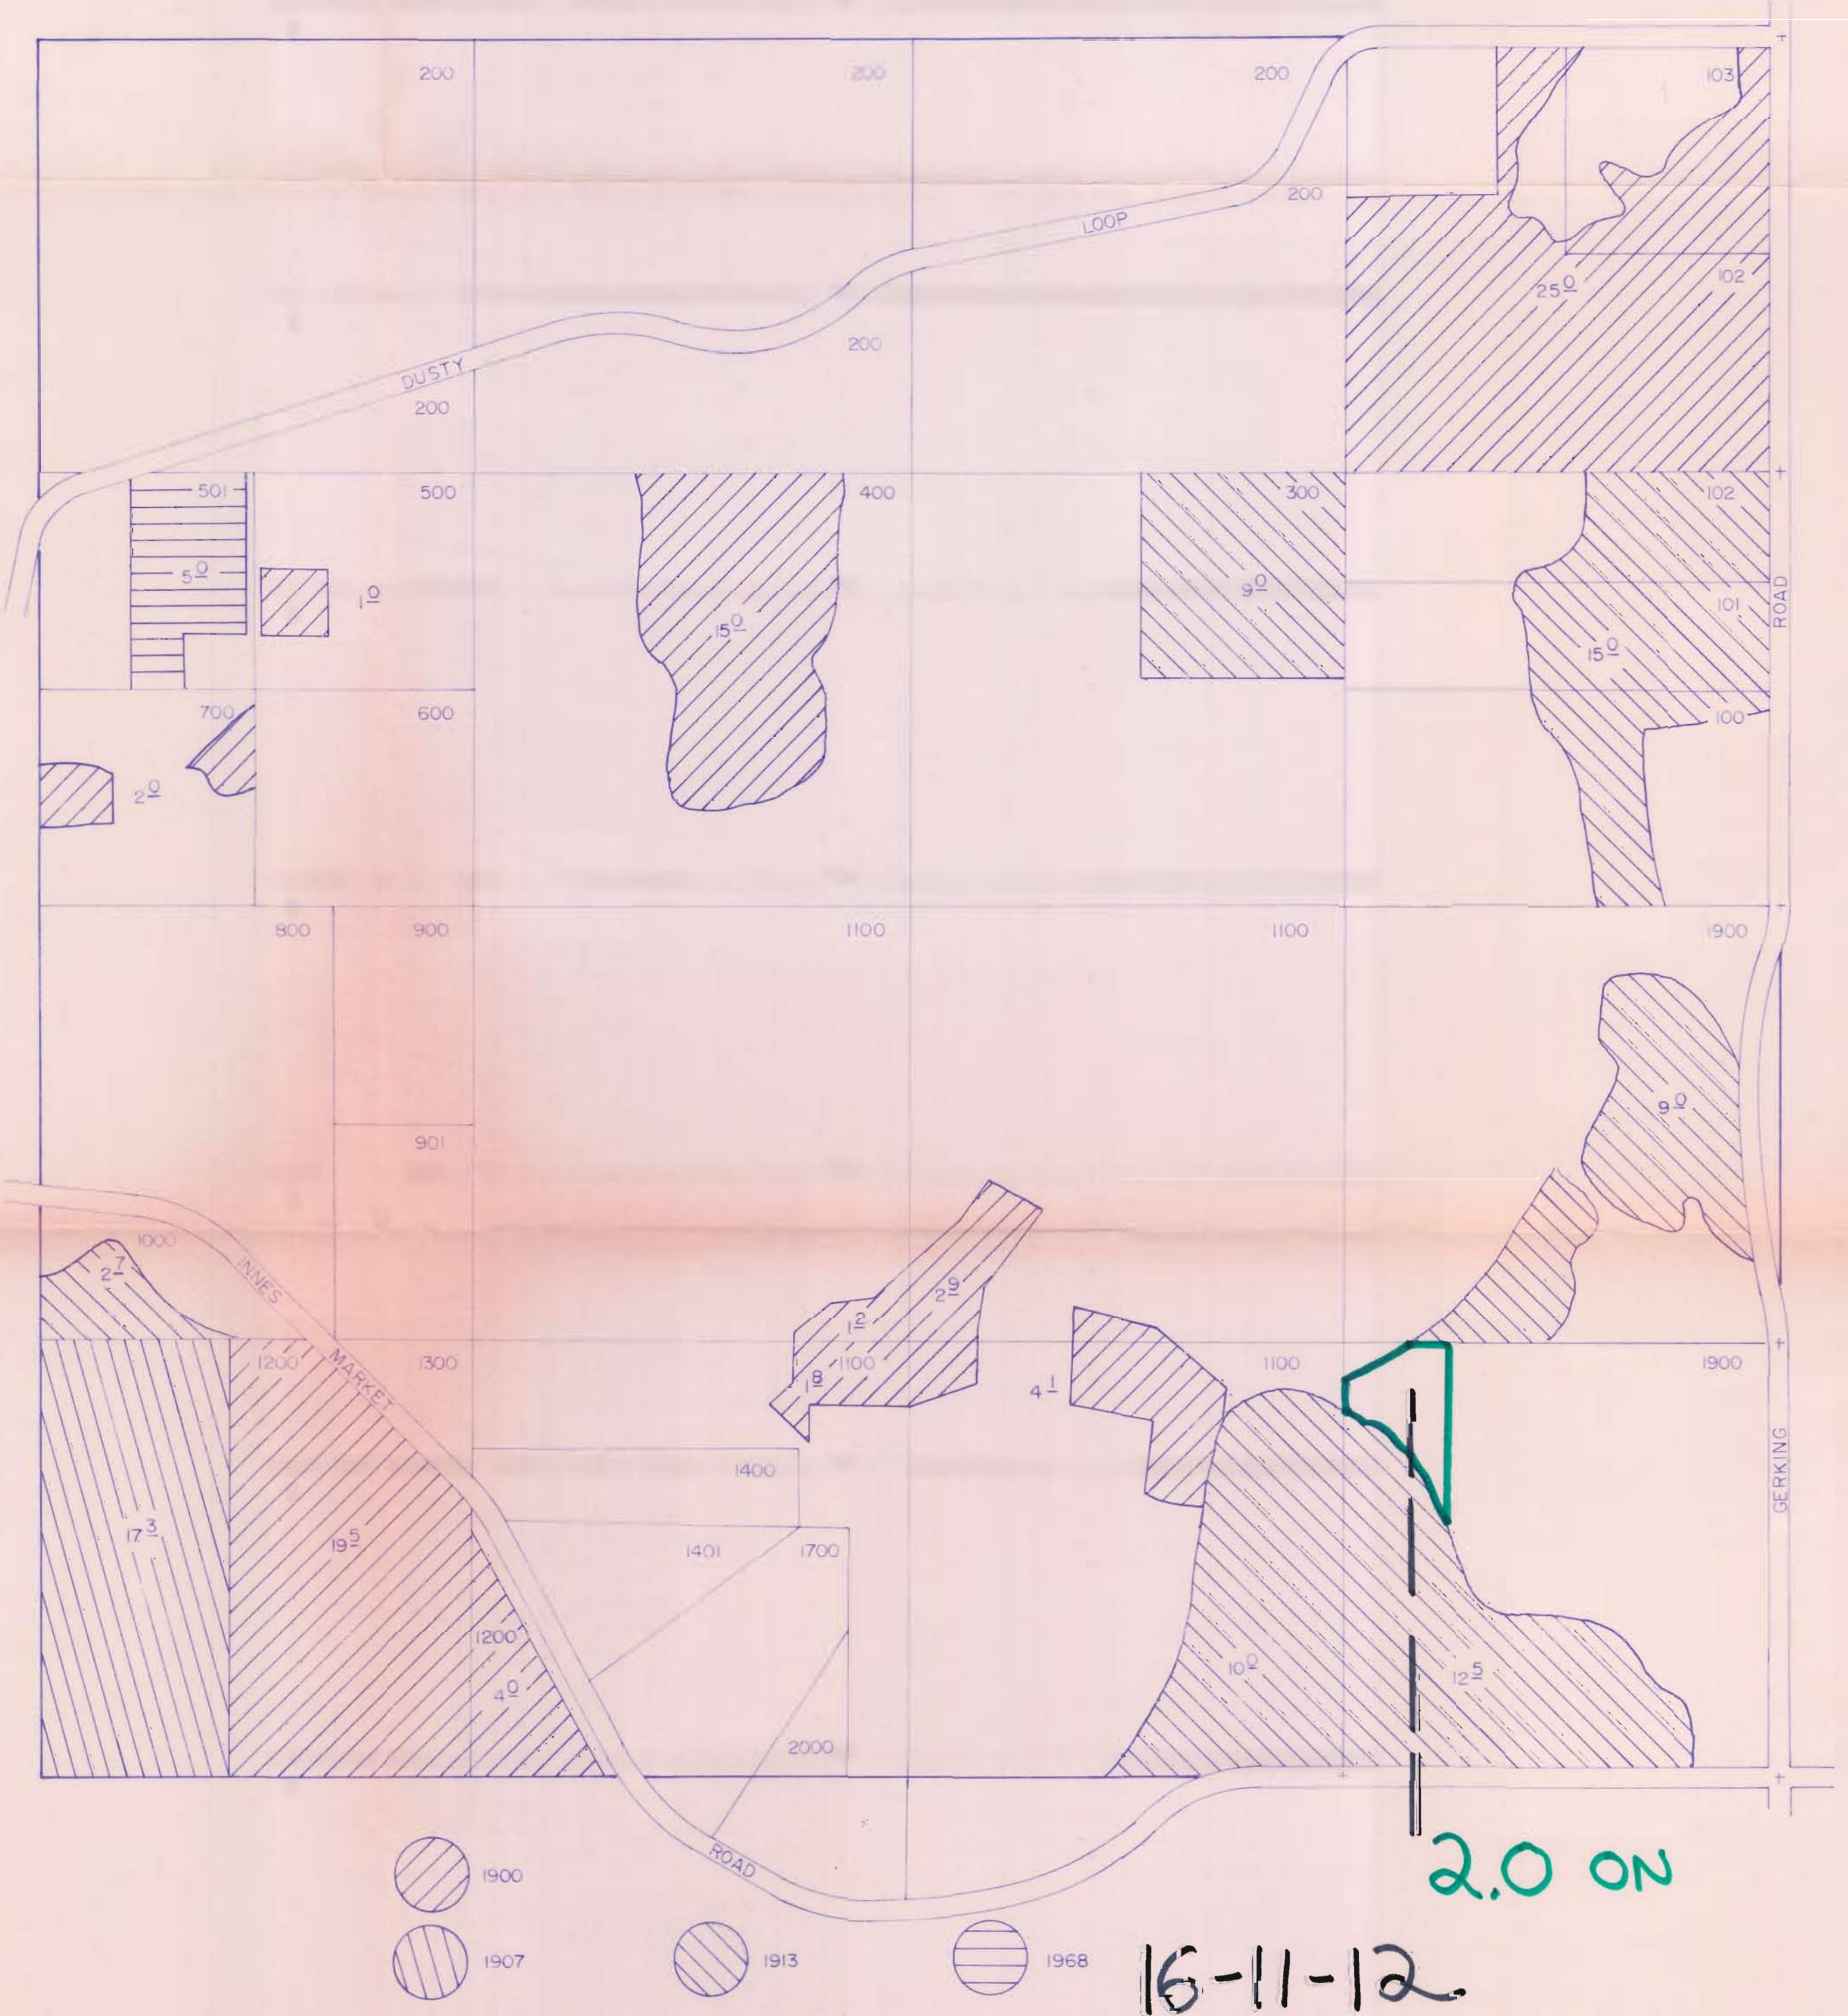

2.0 ON

16-11-12