

TOWNSHIP 39 S. RANGE 8 W. W. M.

JOSEPHINE COUNTY


SCALE 1" = 400'

RECEIVED


JUL 11 1979

WATER RESOURCES DEPT.
SALEM, OREGON

Map to accompany transfer for
Bob L. Jones

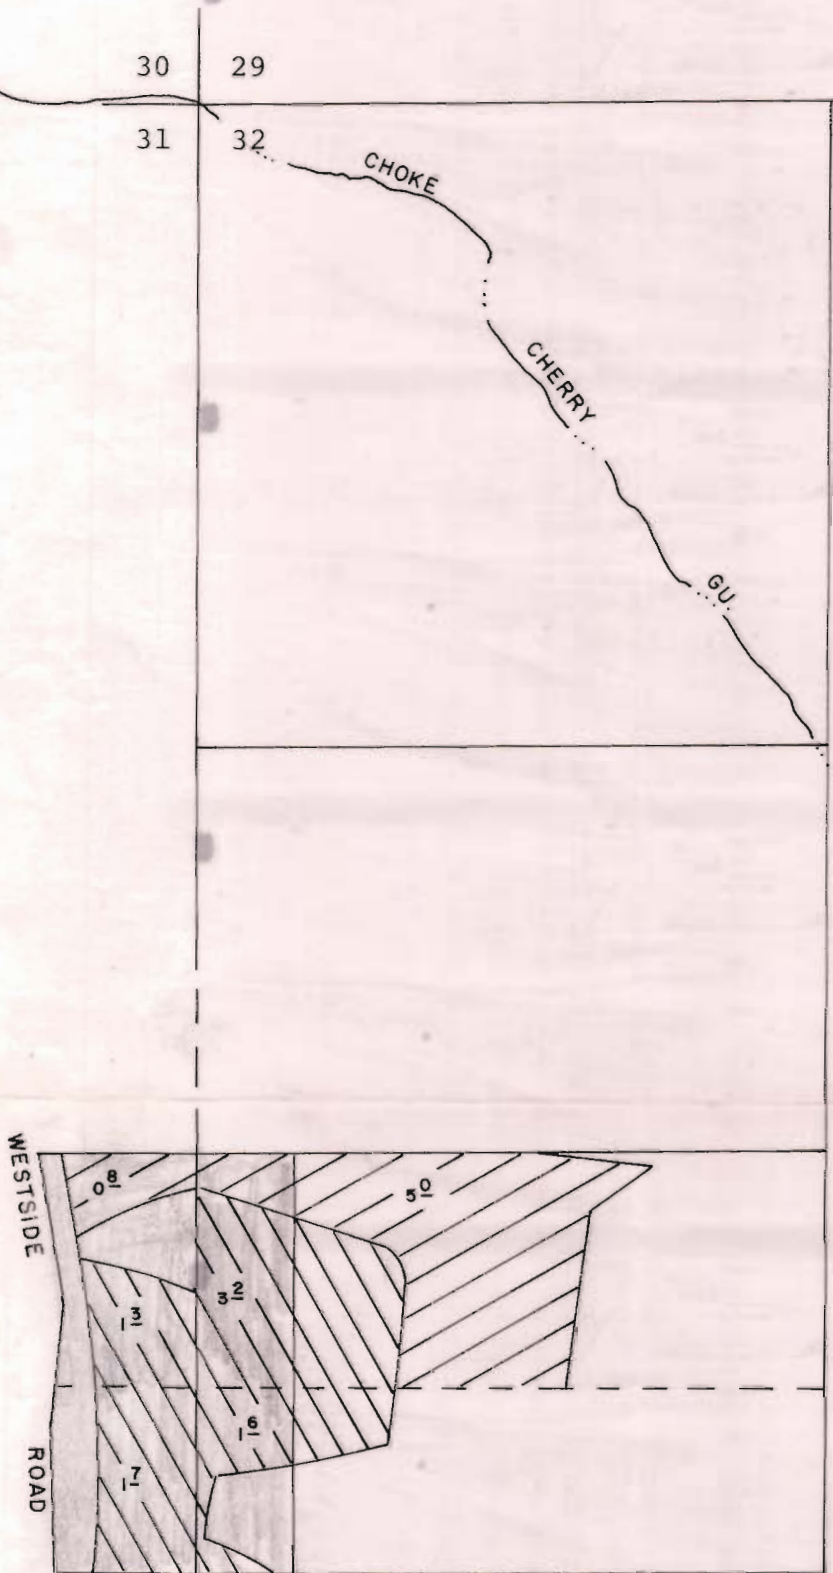

Present Place of Use

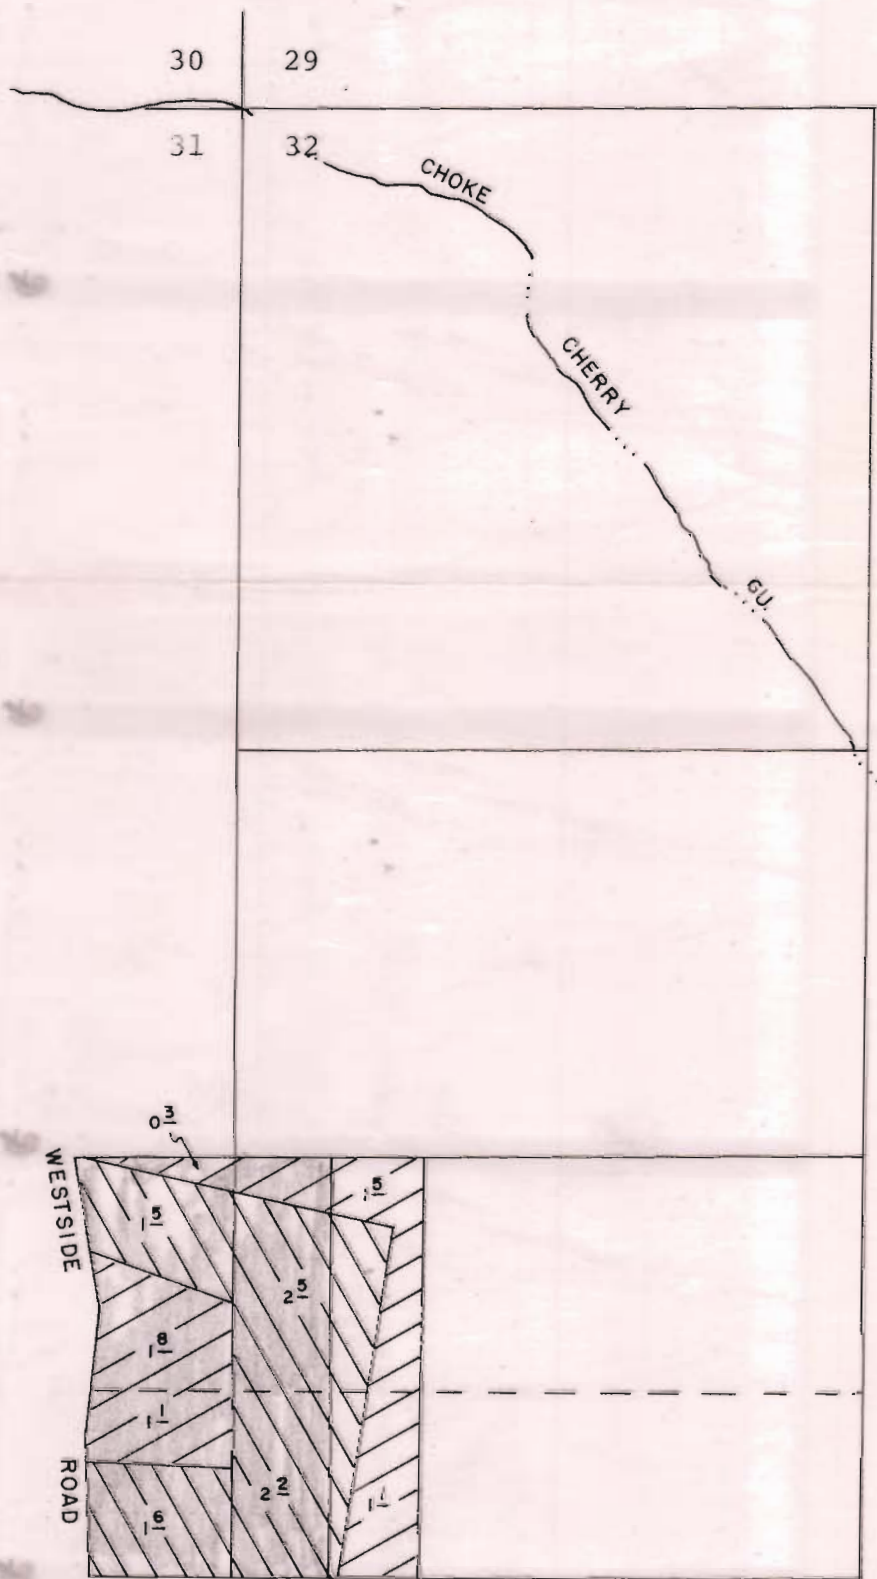

Proposed Place of Use

RECEIVED
JUN 7 1979
WATER RESOURCES DEPT.
SALEM, OREGON



Certificate No. 36456
Priority Date 1873



Certificate No. 15604
Priority Date 1942

T-4234
E
T-4253

THIS MAP PREPARED BY:
Norman E. Joffe
FROM INFORMATION FURNISHED BY
THE APPLICANT.