T-4431

THIS APPLICATION PREPARED BY:

FROM INFORMATION FURNISHED BY THE APPLICANT.

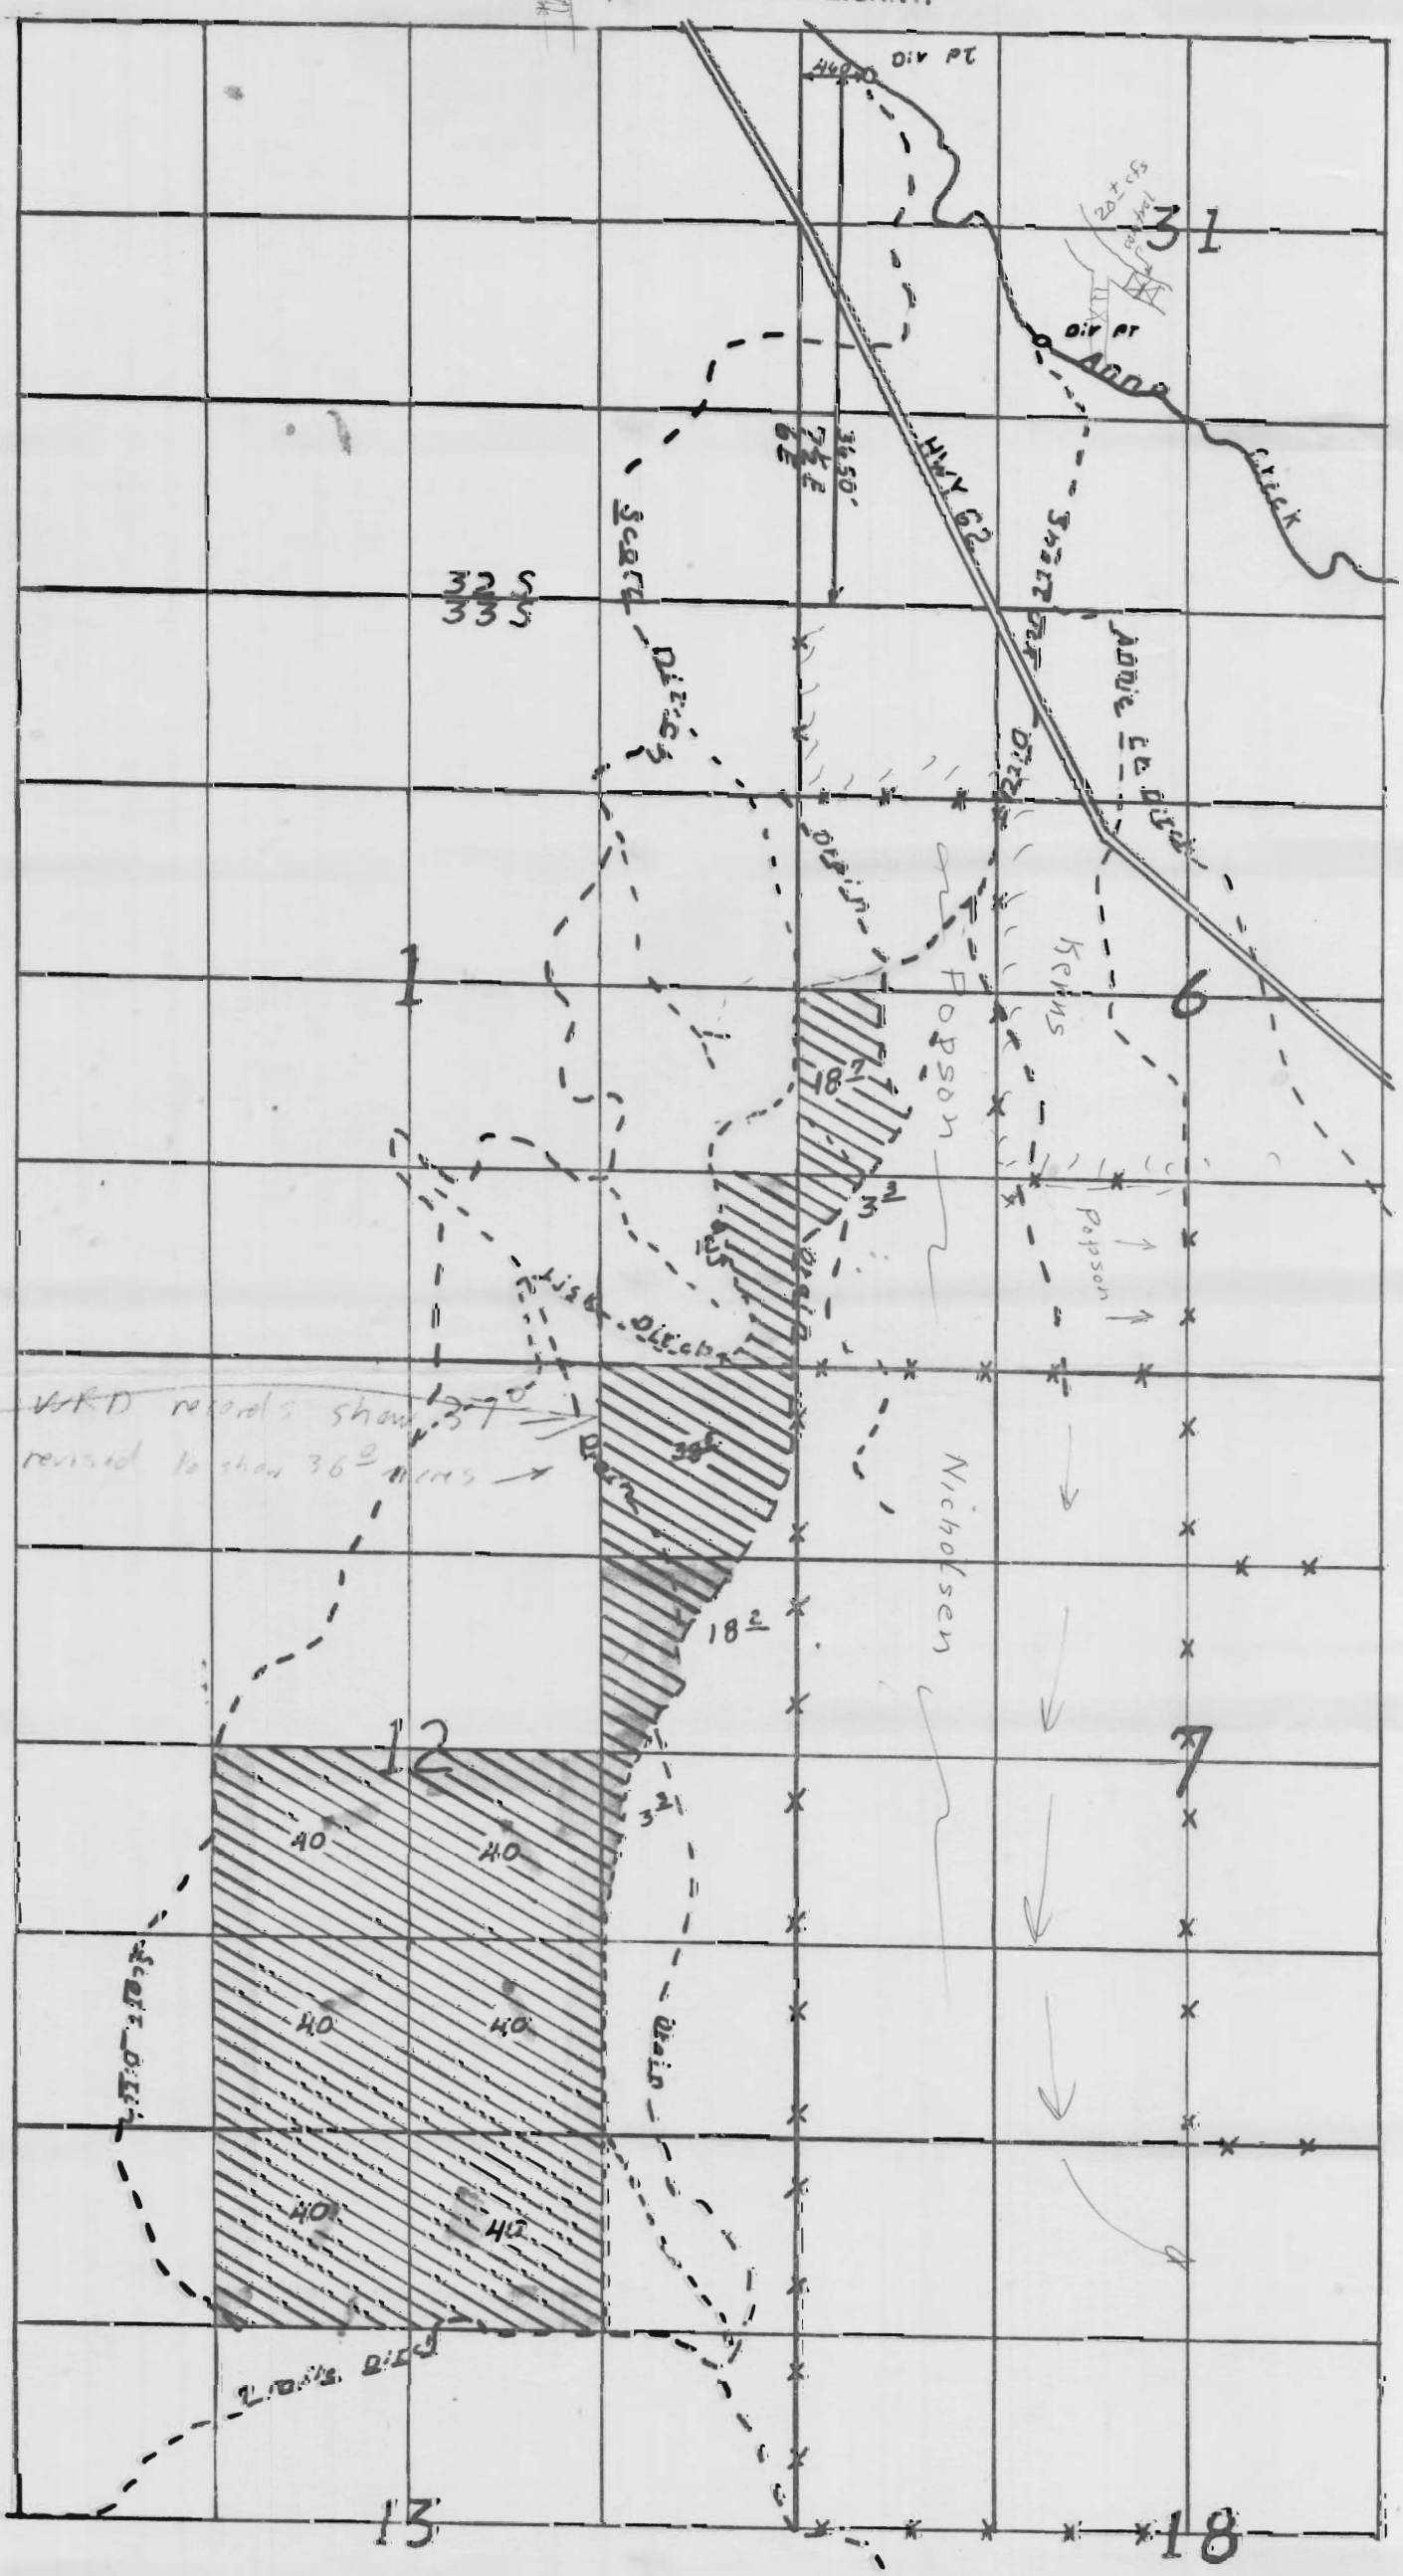

Sec 1 & 6 is Cert # 10913
Sec 12 & 13 is Cert # 10913

TRANSFER MAP

Construction done in 1981 provided for water being run via this course and lands were so irrigated during 1981 irrigation season, beginning in July.

CARUER