

Section 32, T.16S. R.12E.W.M.

DESCHUTES COUNTY


1" = 400'

dead numbers
603
800A-1
702

RECEIVED
NOV 12 1980
WATER RESOURCES DEPT
SALEM, OREGON

See Map 16 12 29

29

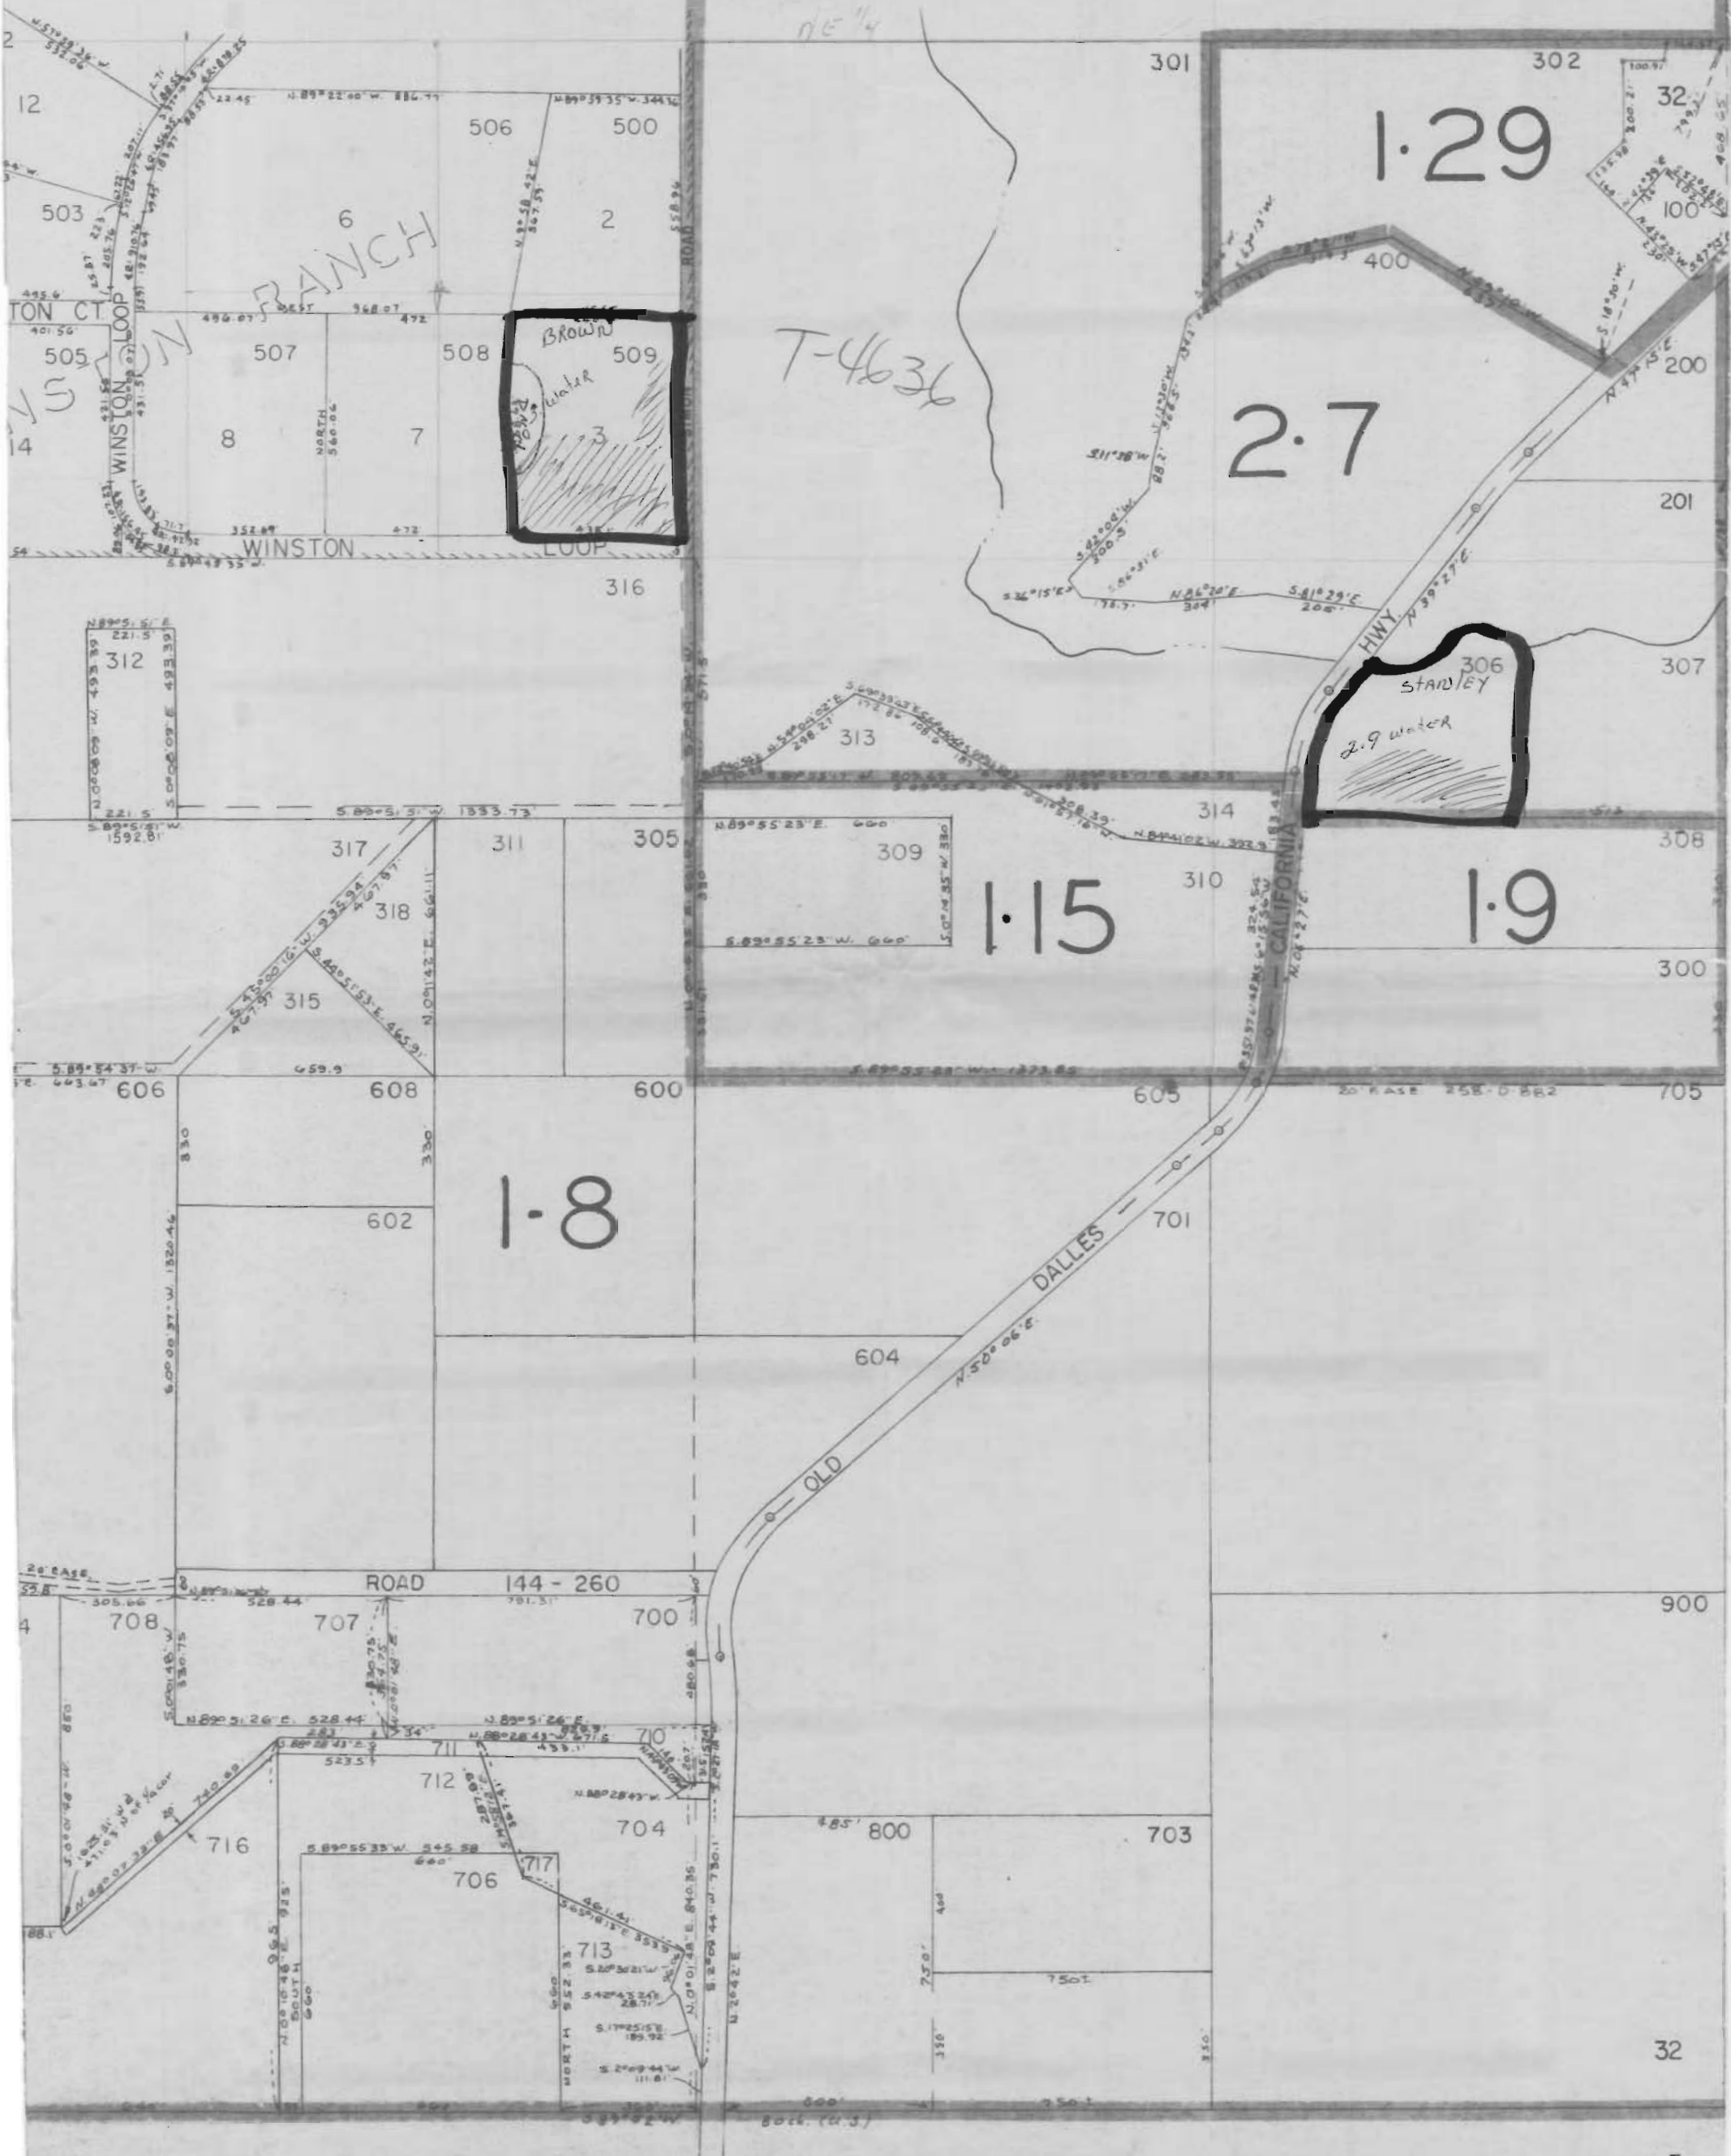

See Map 17 12

5


RECEIVED

NOV 12 1980

WATER RESOURCES DEPT
SALEM, OREGON

See Map 16 12 29

2.7

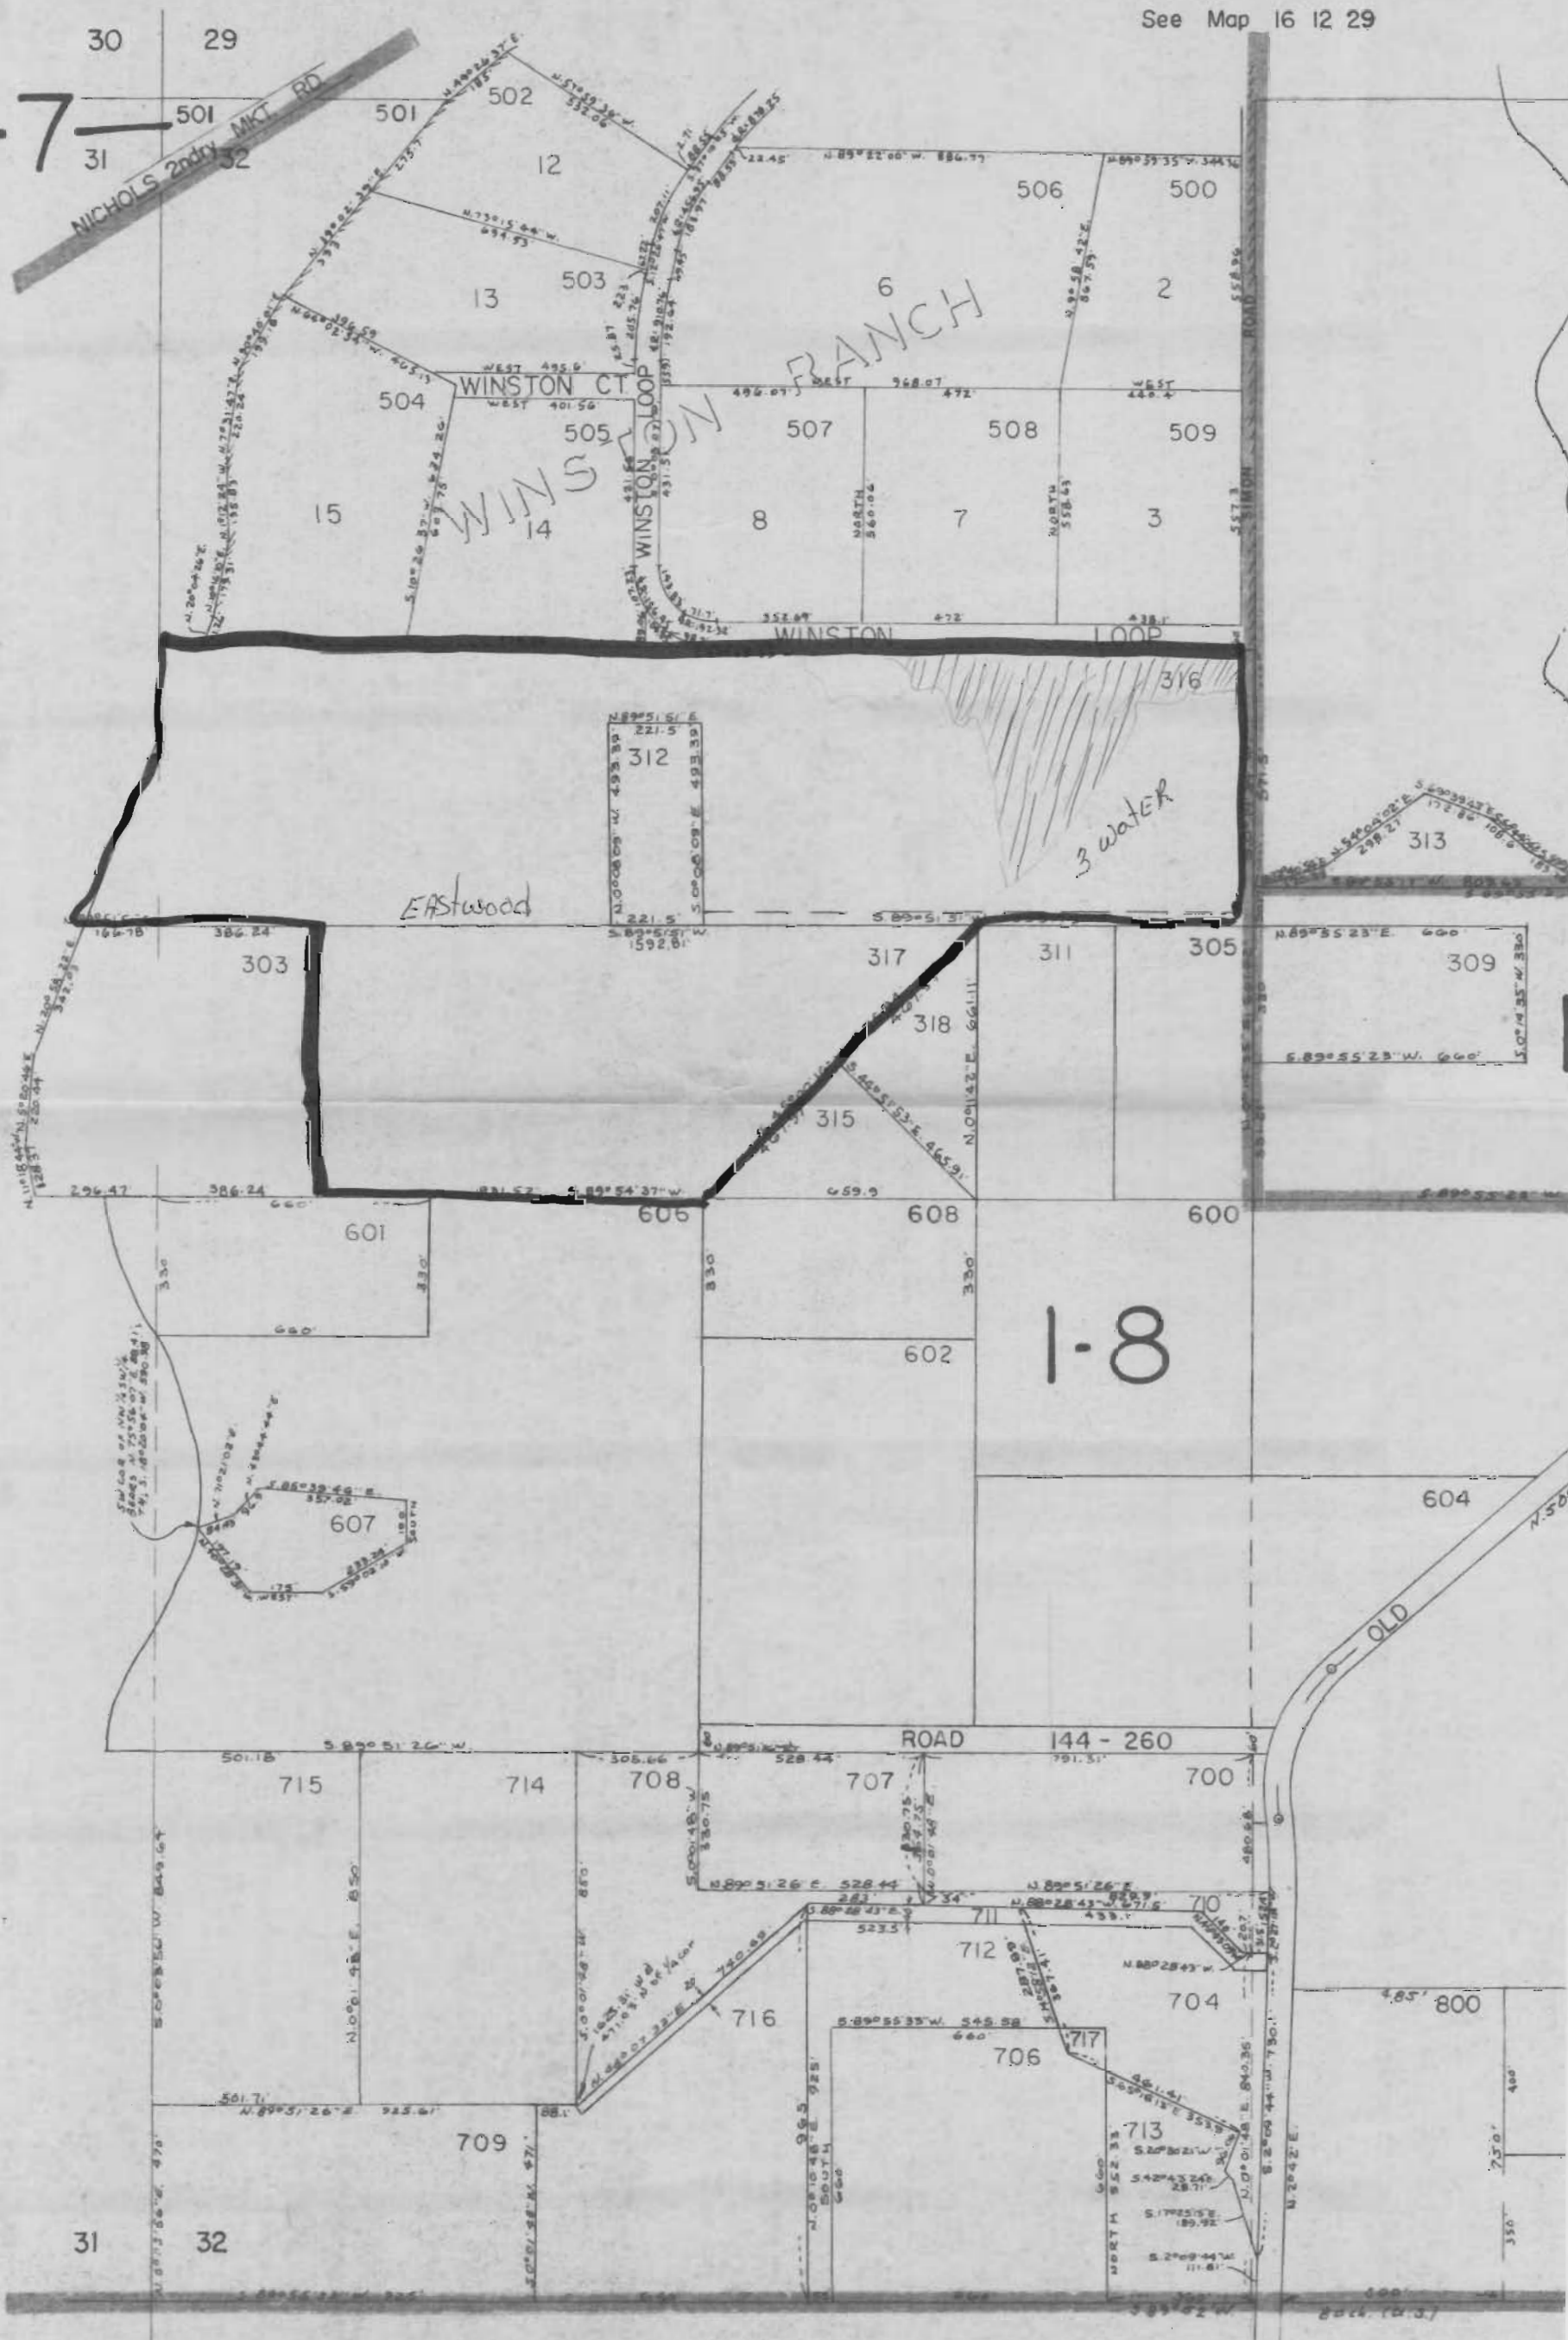

See Map 17 12

DESCHUTES COUNTY

SCALE: 1" = 200'


RECEIVED
NOV 12 1980
WATER RESOURCES DEPT
SALEM, OREGON

Tax Lot 1401 Dead
99
1500
501
1302

See Map 17 12 21C



See Map 17 12 28A

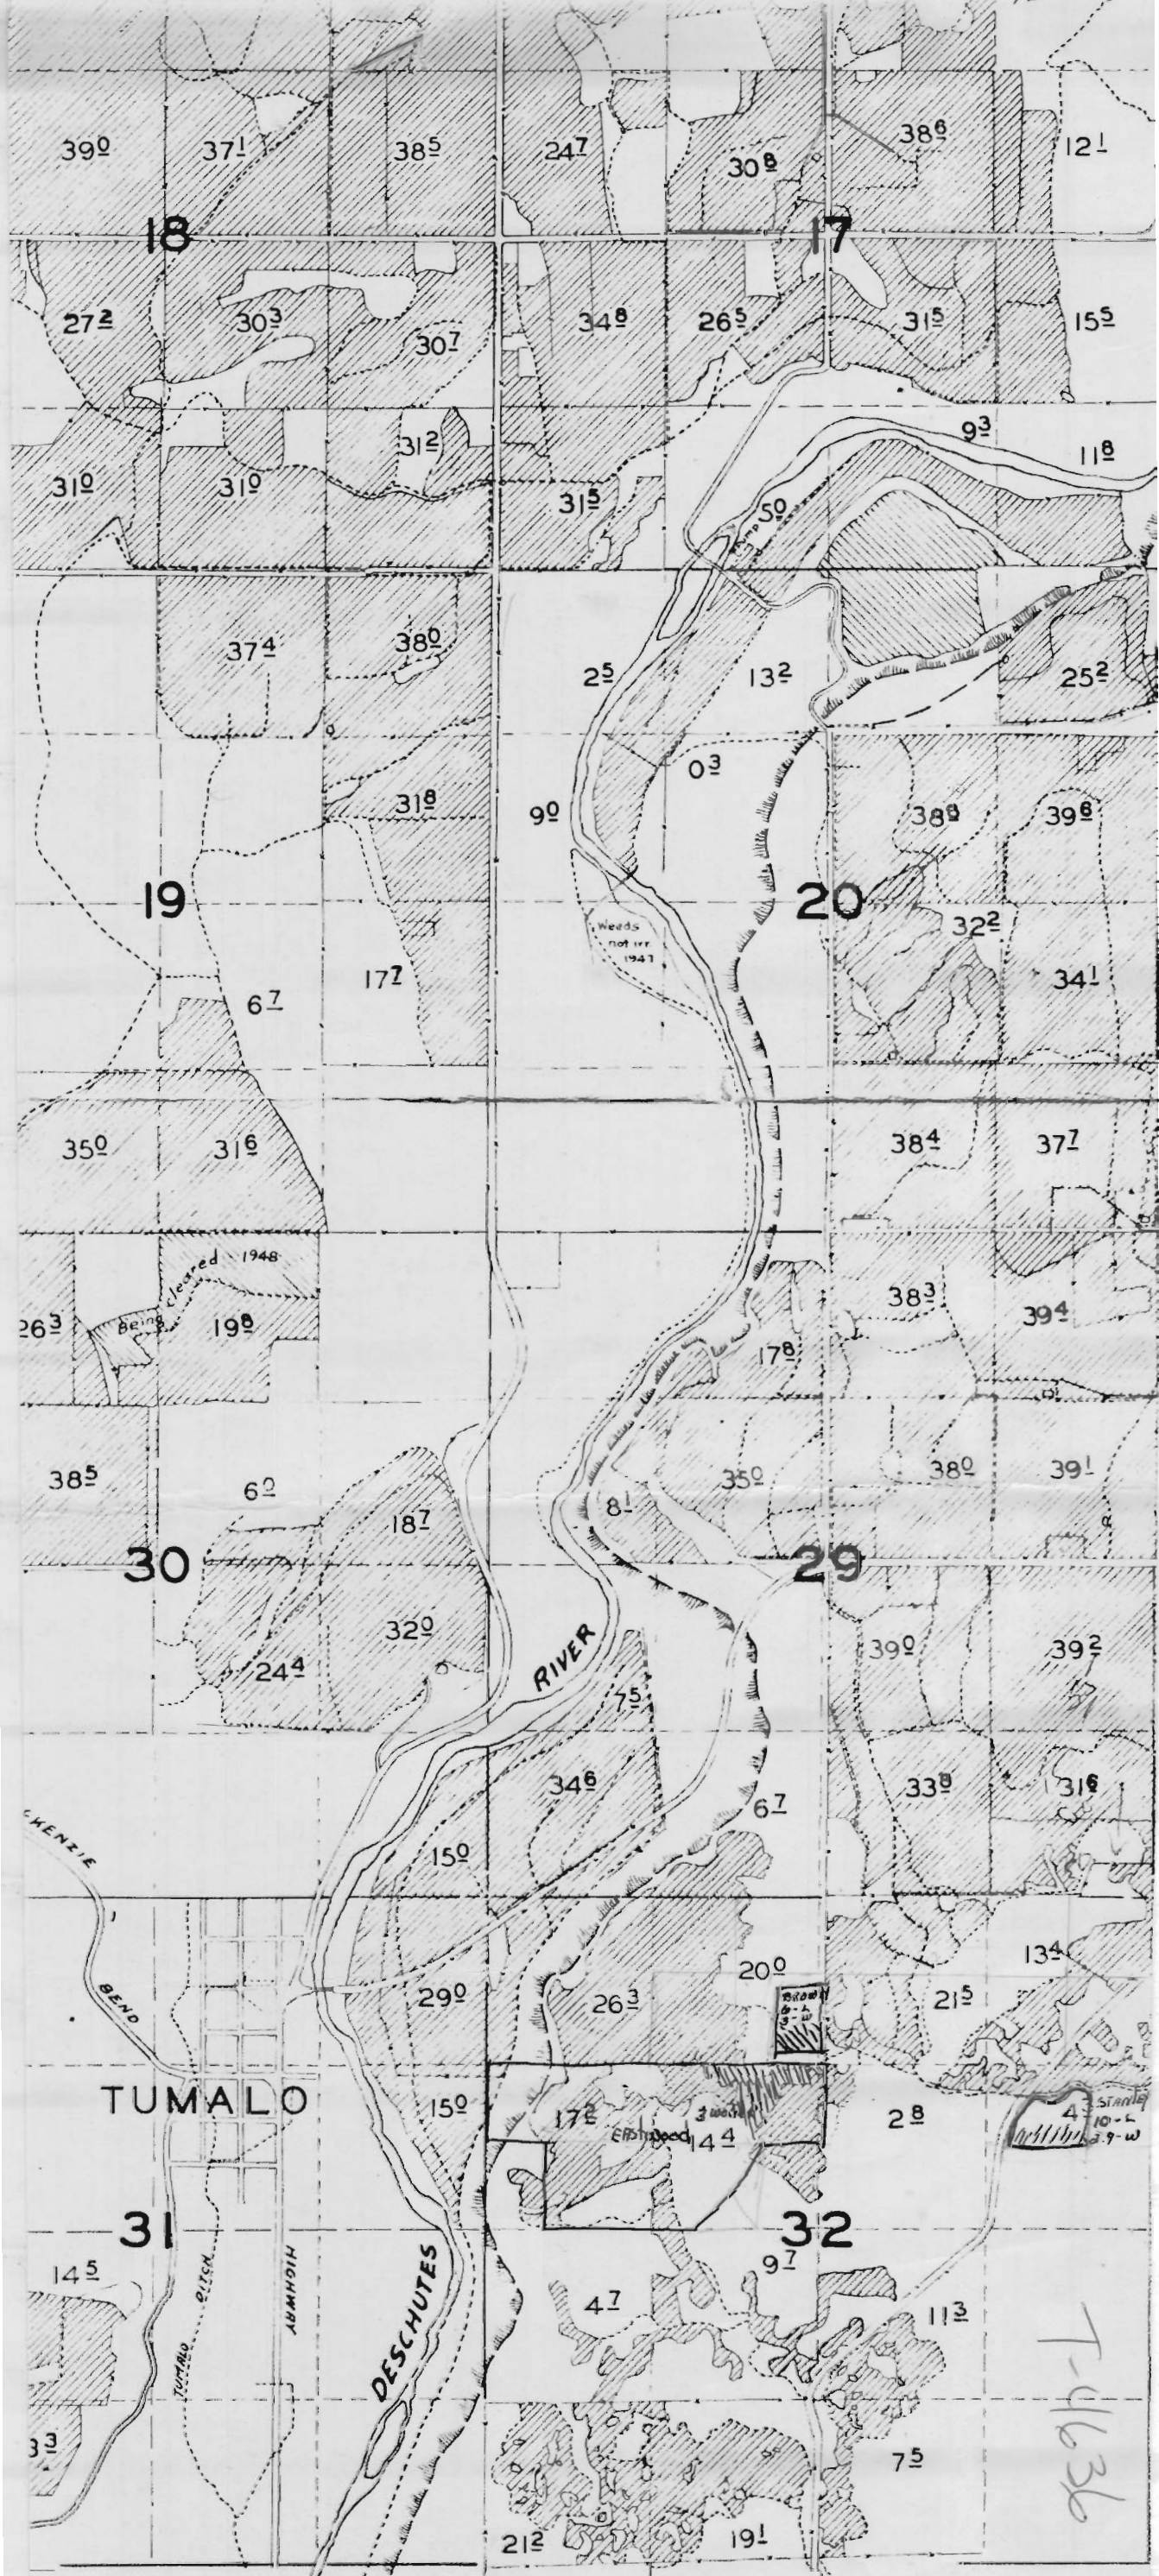

RECEIVED

NOV 12 1980

WATER RESOURCES DEPT

SALEM, OREGON

T-4634

17-12-

RECEIVED
NOV 12 1980
WATER RESOURCES DEPT
SALEM, OREGON

