


T.38S., R.4W. W.M.

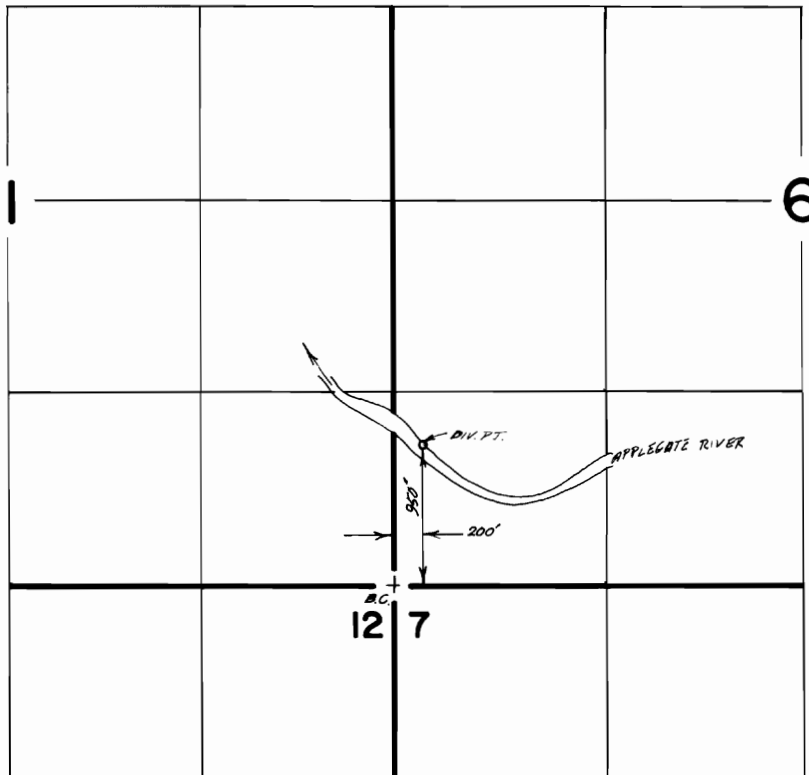

Scale 1"=1320'

**FINAL PROOF SURVEY**

UNDER

**TRANSFER NO. 4729**

Application No. .... Permit No. ....  
IN NAME OF

**MURPHY...ELECTRIC...IRRIGATION...INC.**

Surveyed July..26.. 1983., by B.S..JAMES.....