


T.37 S., R.6 W., W.M.

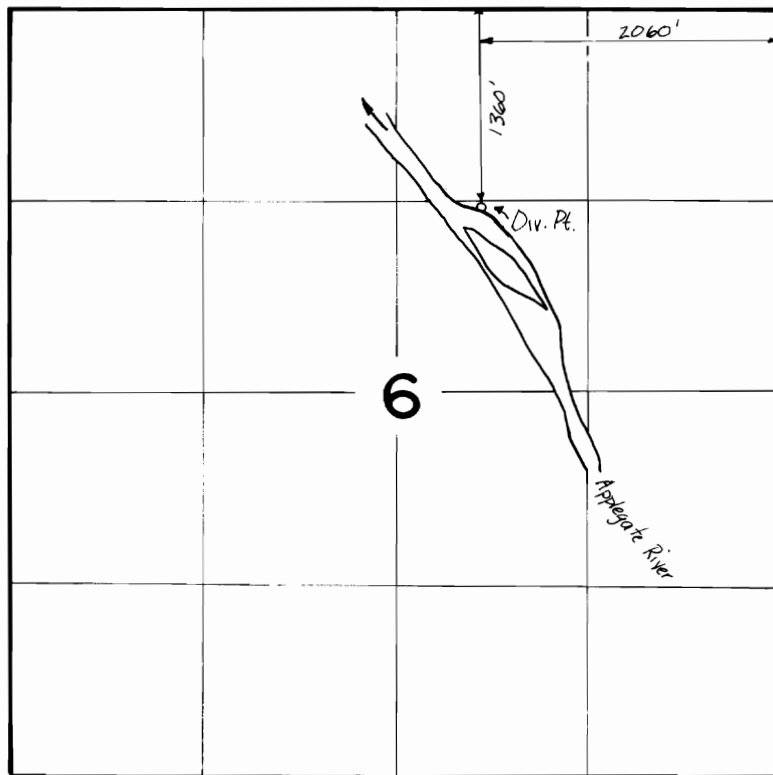

FINAL PROOF SURVEY
UNDER

TRANSFER NO. 4731

IN NAME OF

ROBERT A. & KAY J. WATTS

Surveyed OCT. 18, 1983, by B. S. JAMES