

T-4736

4⁰ ACRES OFF

4" = 1 MILE APPROX.

- T-4736 4⁰ AC
- T-4483 1⁰ AC
- T-9545 7⁰ AC
- T-4380 5⁰ AC

RECEIVED
28

APR 8 1981

WATER RESOURCES DEPT.
SALEM, OREGON



MCKENZIE

HIGHWAY

18

17

16

19

20

21

1.2 ACRES OFF
4" = 1 MILE APPROX.

REDMOND MUNICIPAL RESERVOIR


Chlorination Plant 2

T-4483

HORN

FORKED BUTTE

RECEIVED
APR 24 1988
WATER RESOURCES DEPT
SALEM, OREGON

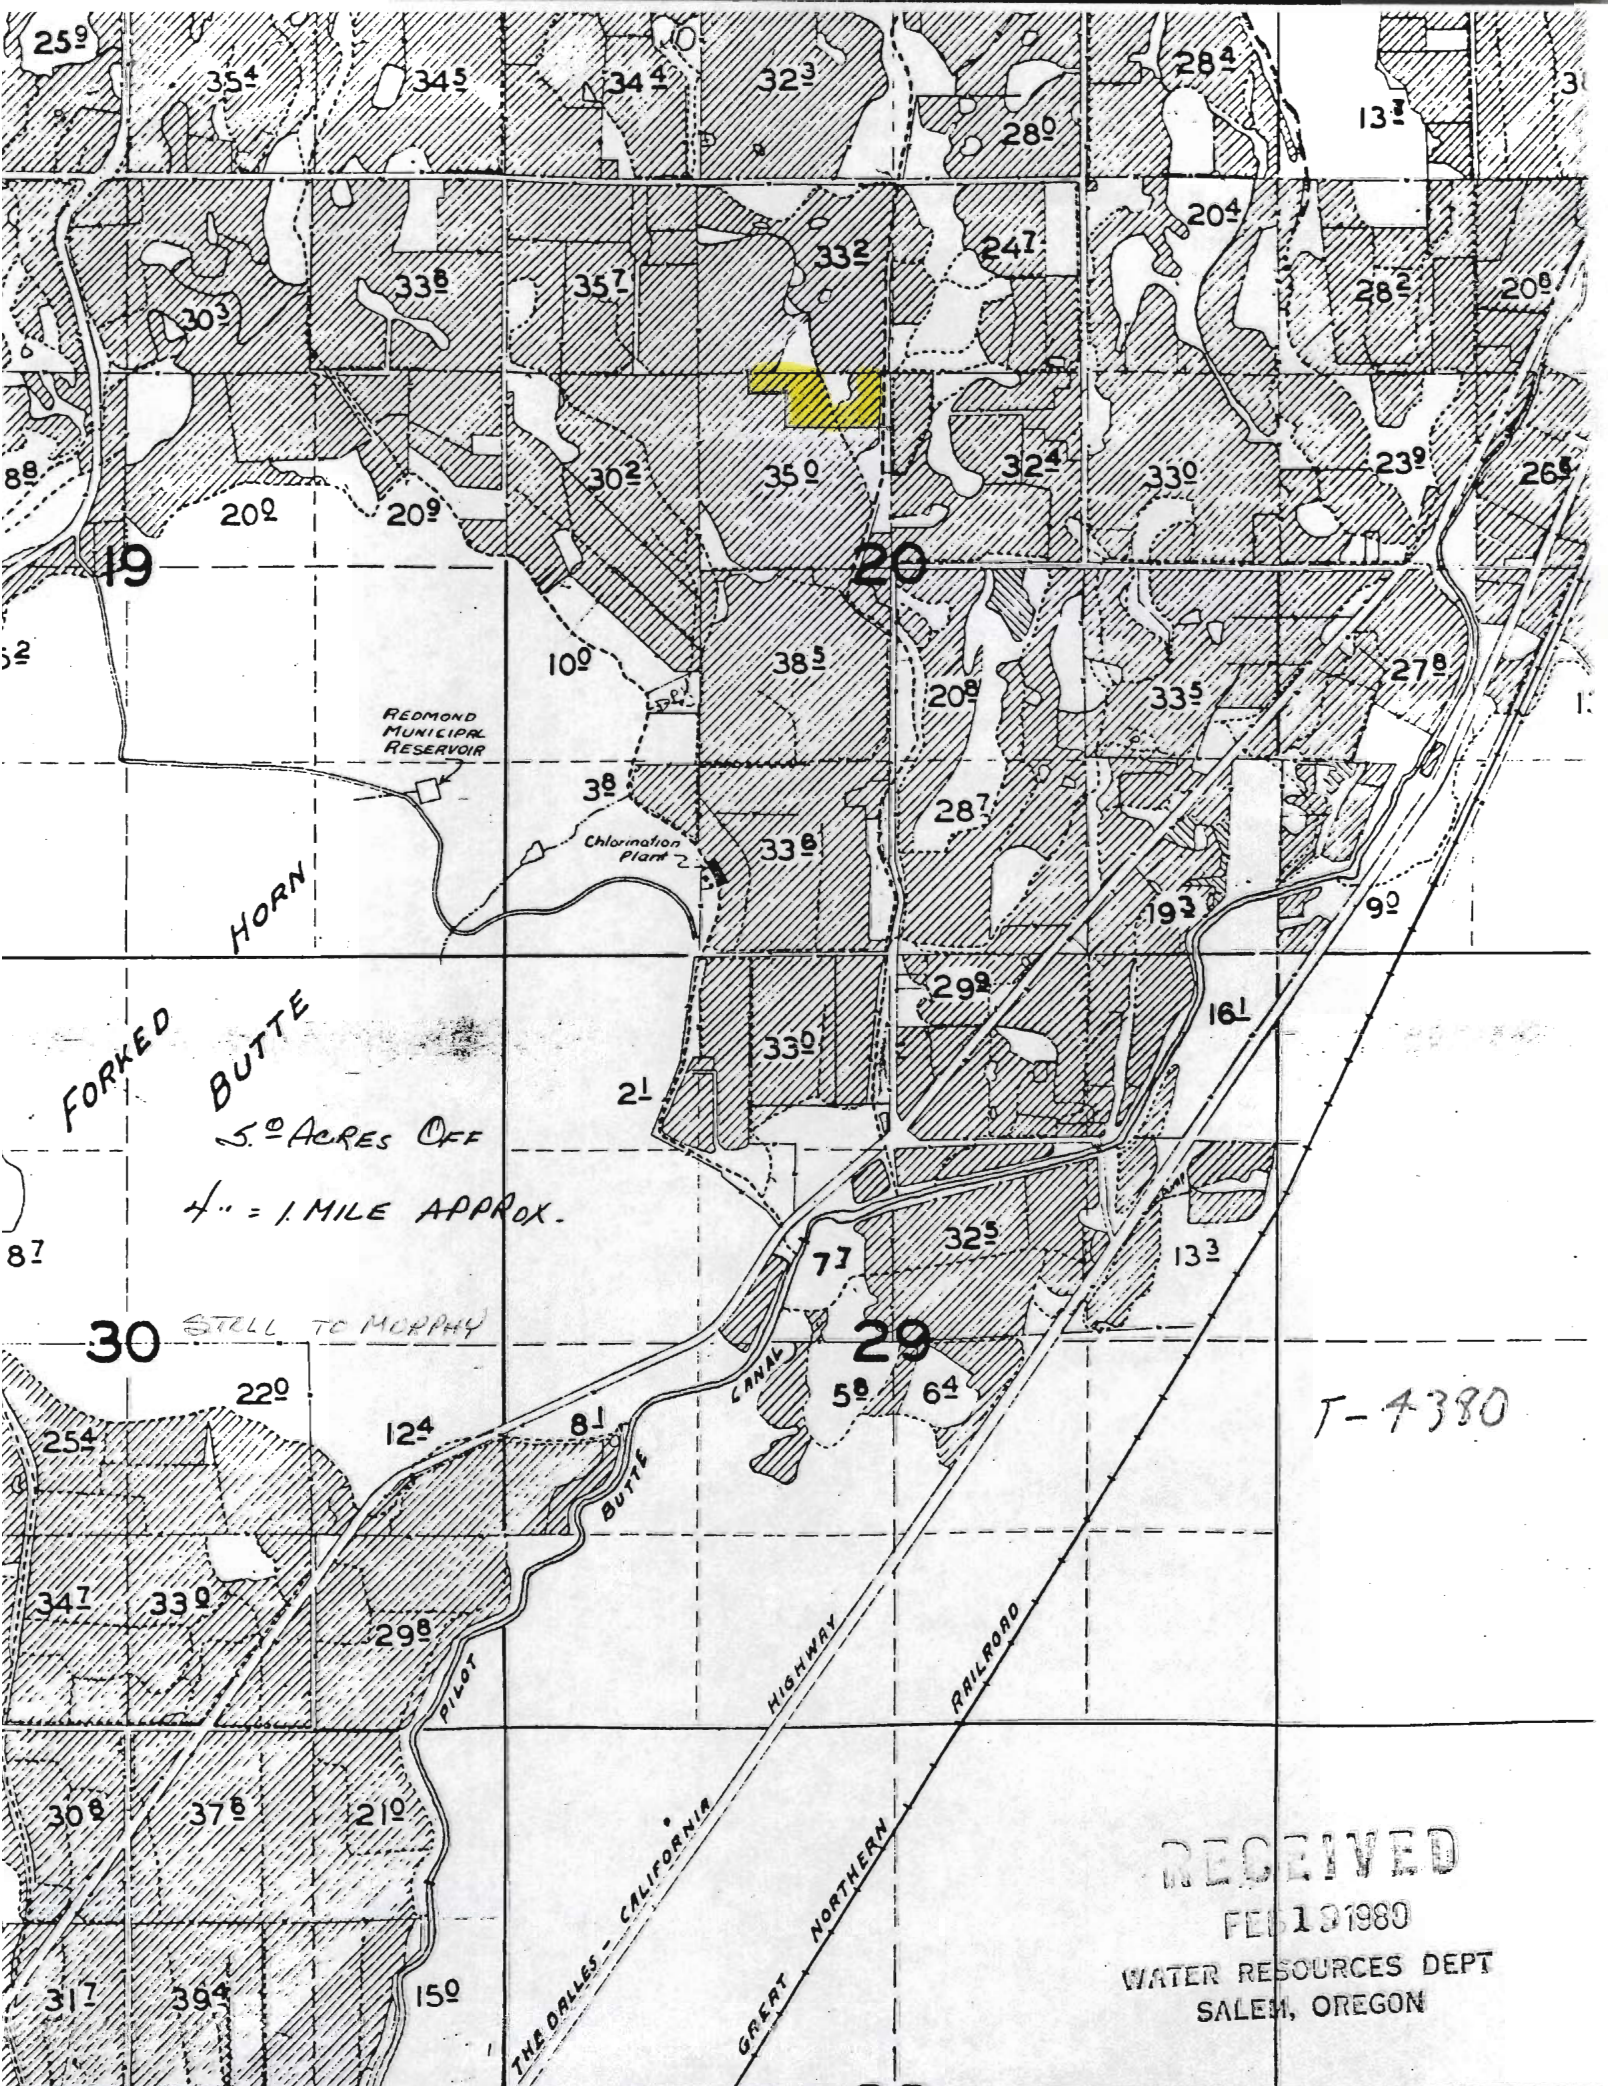

REDMOND MUNICIPAL RESERVOIR

Chlorination Plant 2


FORKED BUTTE
5.0 ACRES OFF

1" = 1 MILE APPROX.

STILL TO MOPPHY

T-4380

RECEIVED
FEB 19 1980
WATER RESOURCES DEPT
SALEM, OREGON

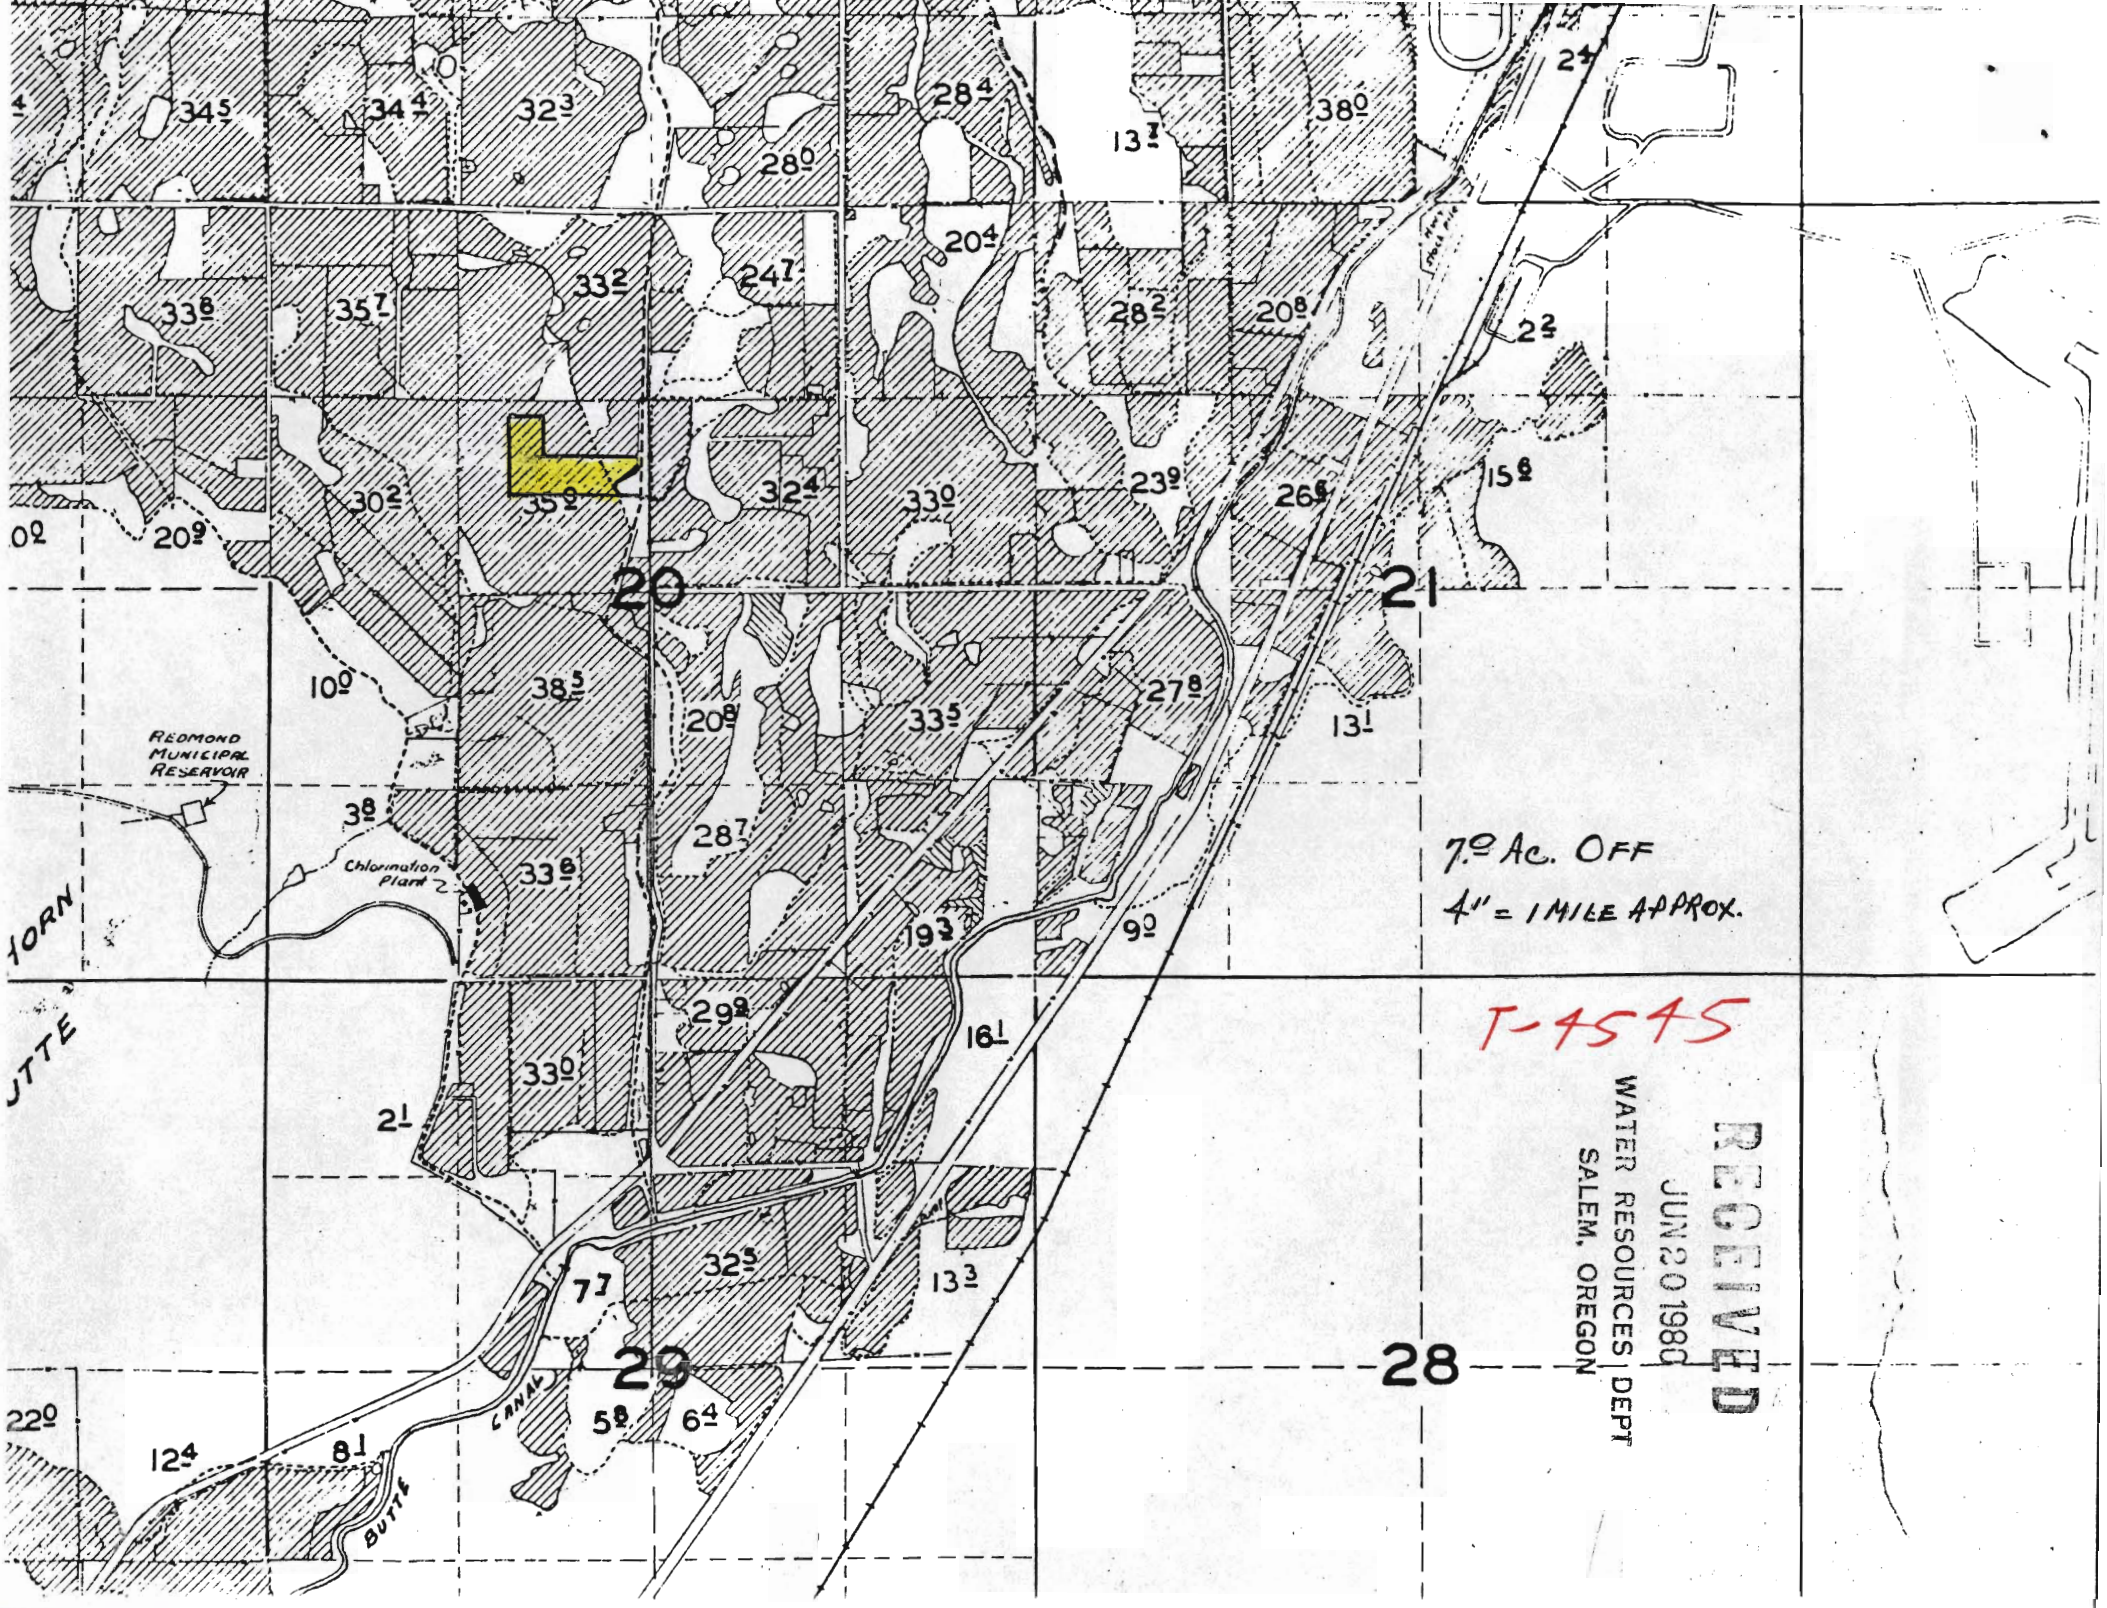

7.0 Ac. OFF
4" = 1 MILE APPROX.

T-4545

RECEIVED
JUN 20 1980
WATER RESOURCES DEPT
SALEM, OREGON