


T. 34 S., R. 1 W., W. M.

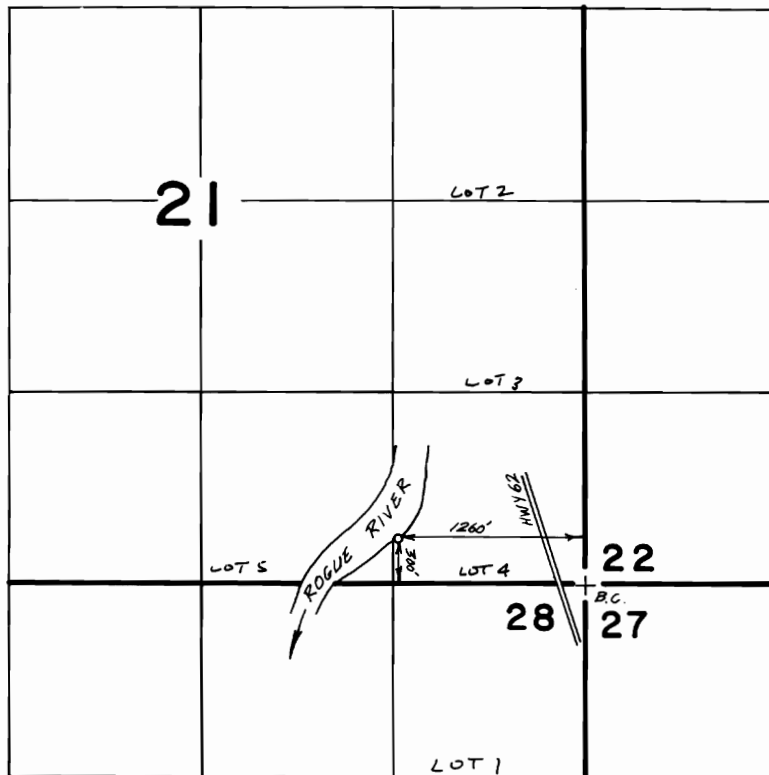

Scale 1"=1320'

FINAL PROOF SURVEY UNDER

Transfer No. 4746

Application No. Permit No.
IN NAME OF

..... **LENA FULLBRIGHT**

Surveyed Oct. 18, 1984, by J.R. WOODROOF