


T. 39 S., R.3W., W.M.

SEC. 15

SE 1/4 SW 1/4

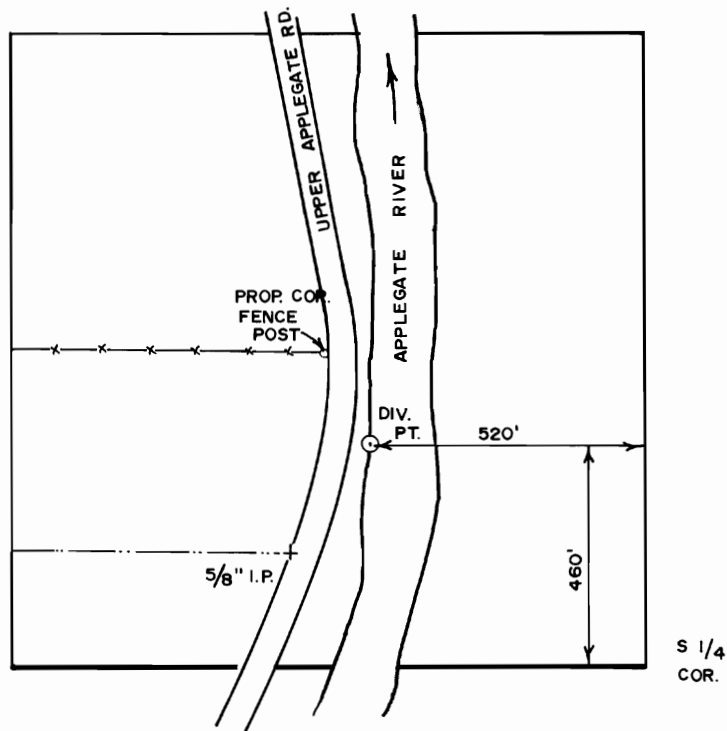

**FINAL PROOF SURVEY**  
UNDER

Transfer No. 4753

Application No. .... Permit No. ....  
IN NAME OF

JOHN E. & GRACE A. KELLER.....

Surveyed April 30, 1982, by B.R. SUND.....

SCALE 1" = 400'