


T-9754

4.0 ACRES ON  
4" MILE APPROX

RECEIVED  
APR 24 1981  
RESOURCES DEPT  
SALEM, OREGON

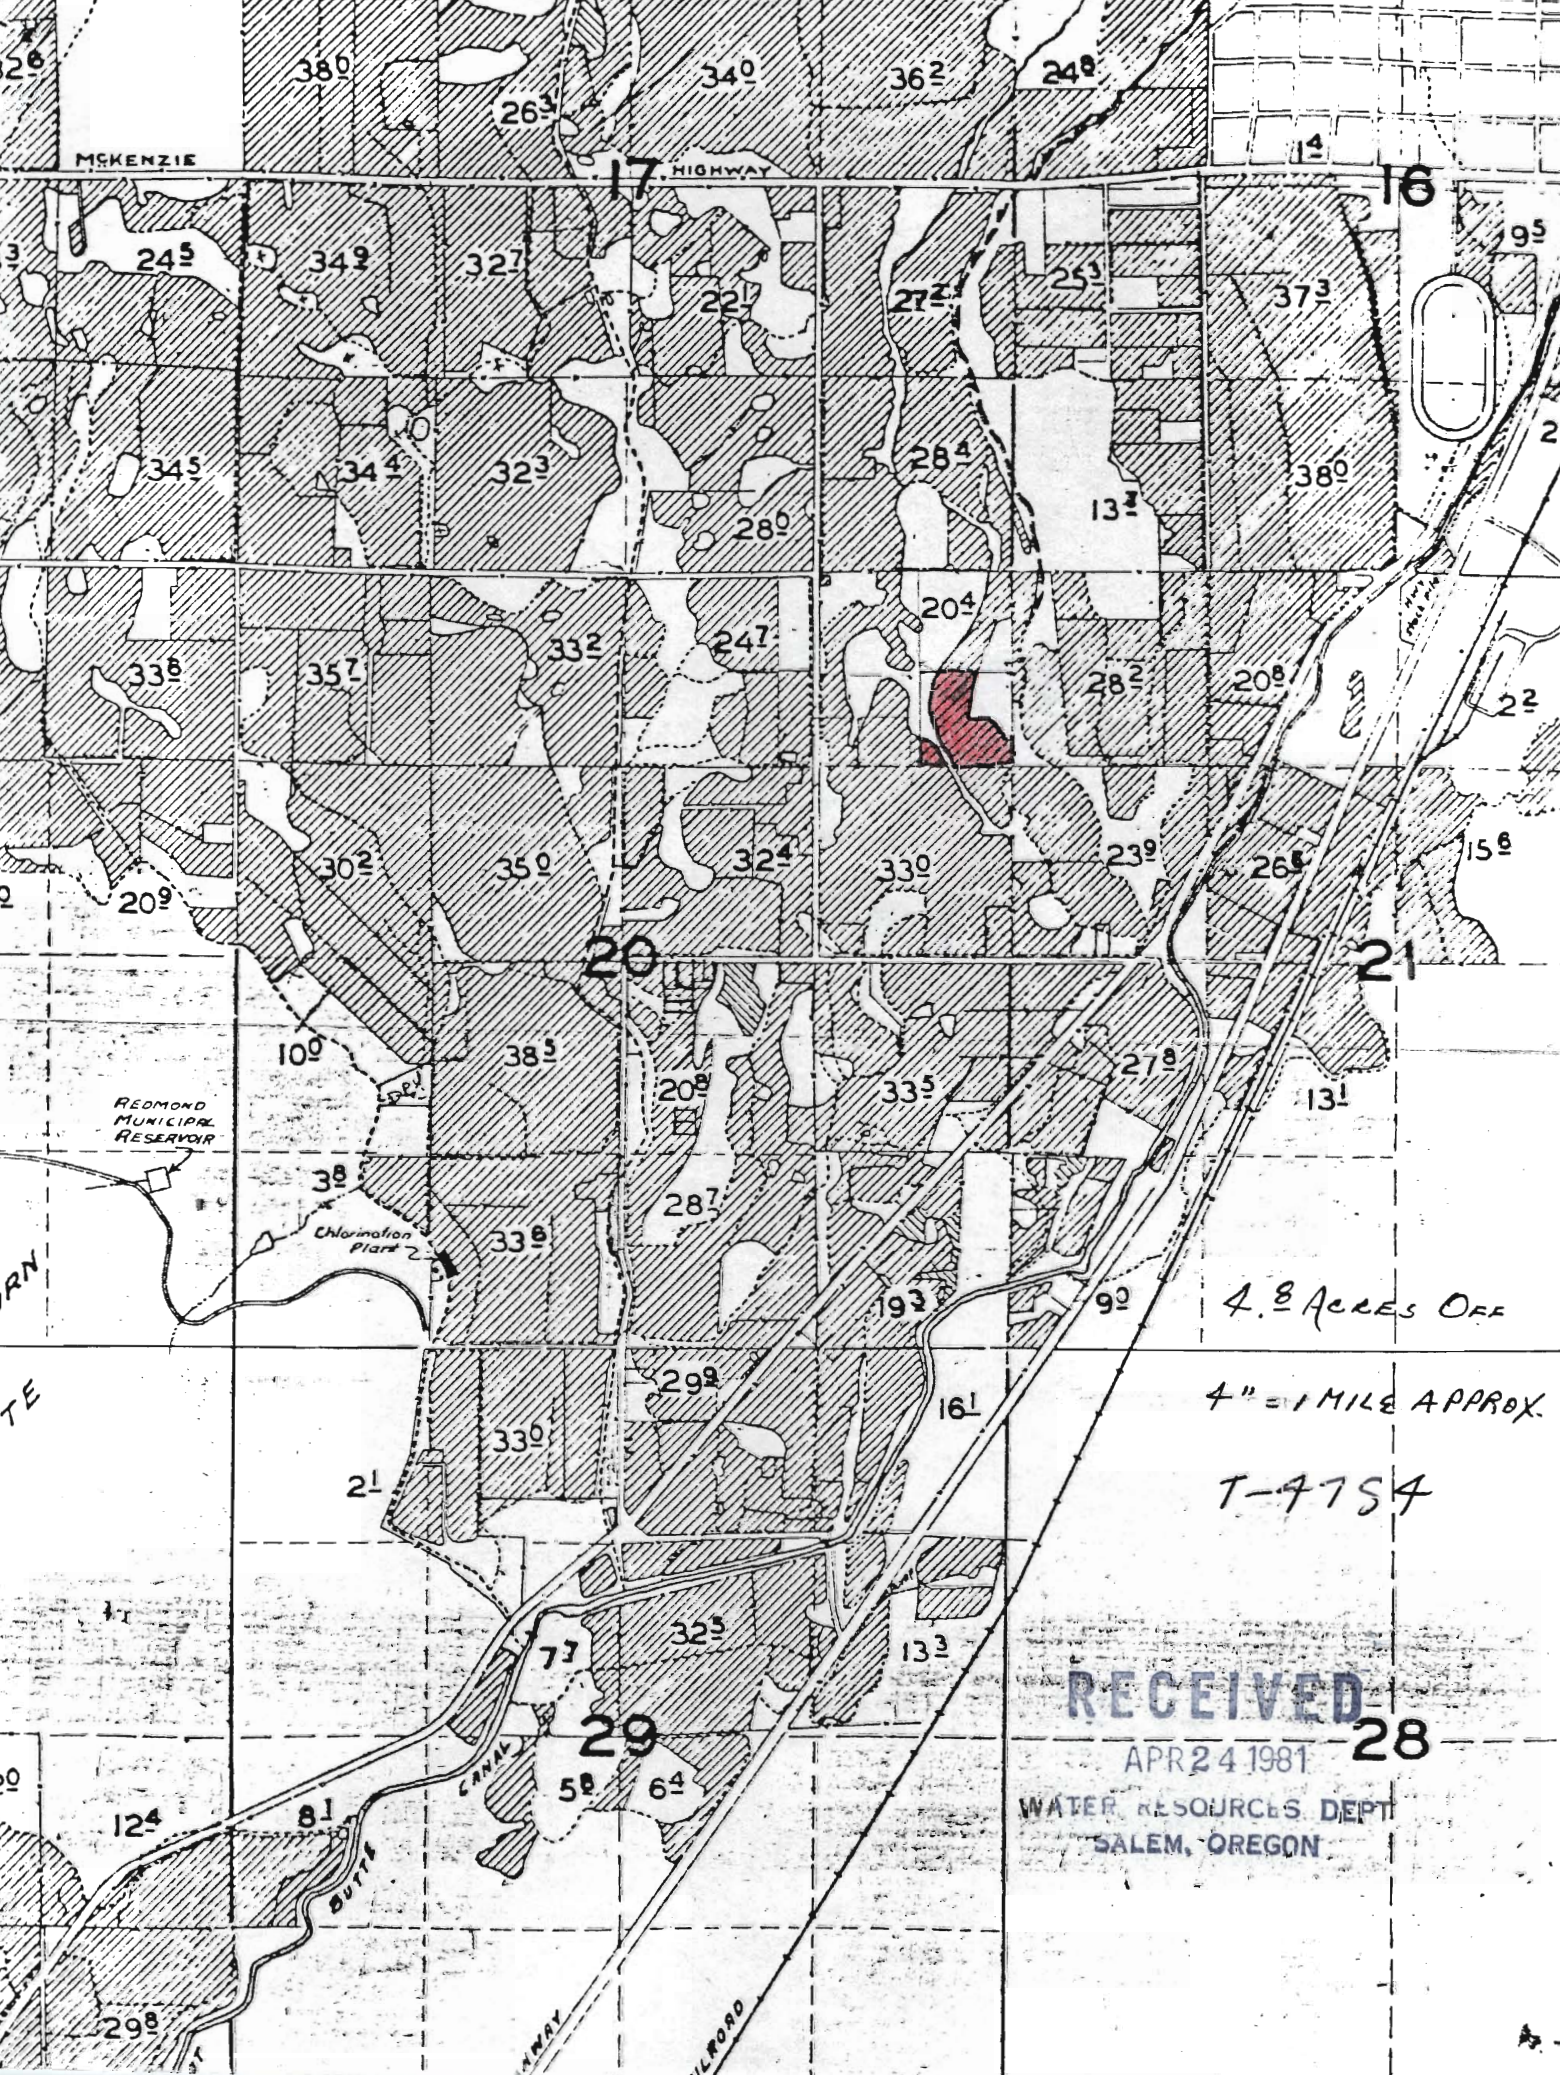

4.8 ACRES OFF

4" = 1 MILE APPROX.

T-7754

RECEIVED

APR 24 1981

WATER RESOURCES DEPT  
SALEM, OREGON

28