


T. 13 S., R. 31 E., W.M.

RECEIVED

JUL 25 1999

WATER RESOURCES DEPT.  
SALEM, OREGON

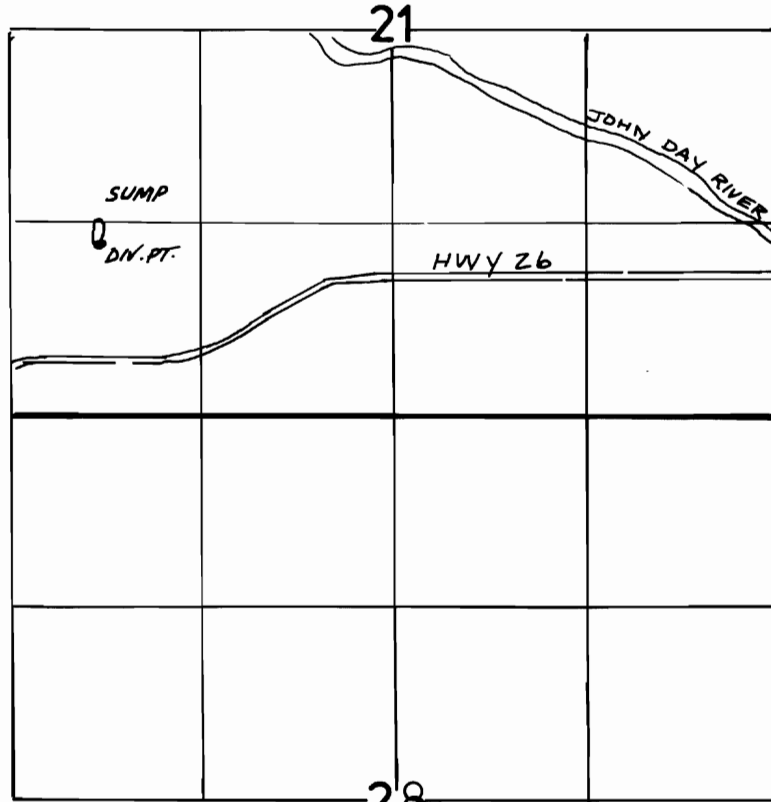

DIV. PT. LOC.: 1480'S & 620'E FROM THE WEST COR. SEC 21.

**FINAL PROOF SURVEY  
UNDER**

TRANSFER NO. 4768

Application No. .... Permit No. ....  
**IN NAME OF**

..... MOUNTAIN VIEW COUNTRY CLUB .....

Surveyed ..July..9, 1999.., by ..J..Miller.....