


T. 10S., R. 1W., W.M.

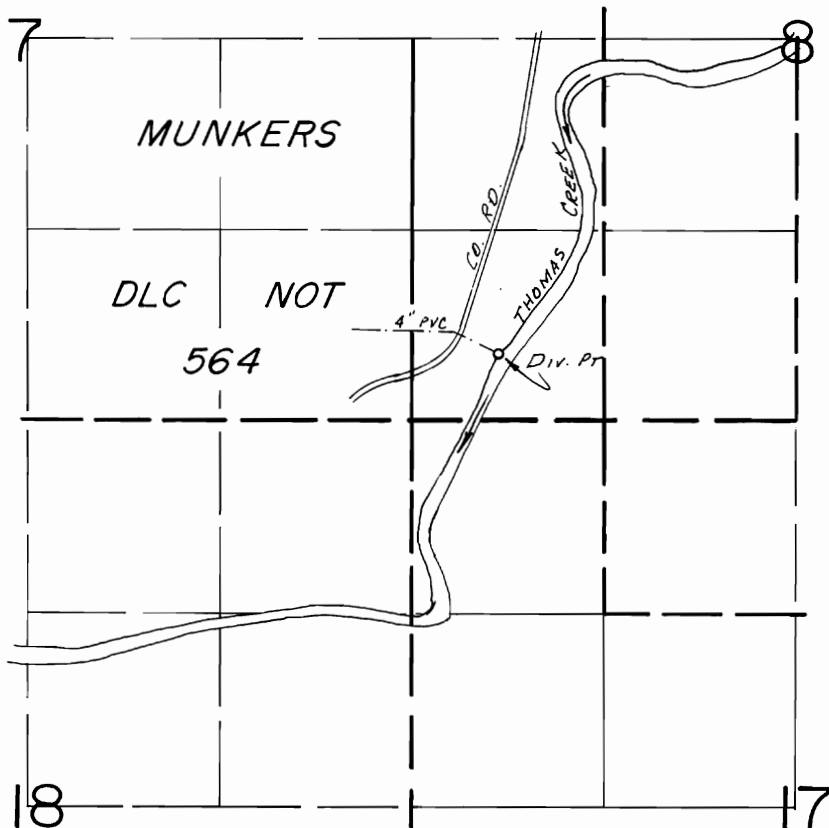

Div. Pt. Loc.: 450' N. & 600' E. FROM SW COR. SEC. 8.

SCALE: 1" = 1320'

FINAL PROOF SURVEY UNDER

Transfer No. 4785

IN NAME OF

..... SCIO SCHOOL DISTRICT 95C

Surveyed May 1..... 19.84, by L.M. TOLL.....