


T. 13S., R. 33E., W. M.

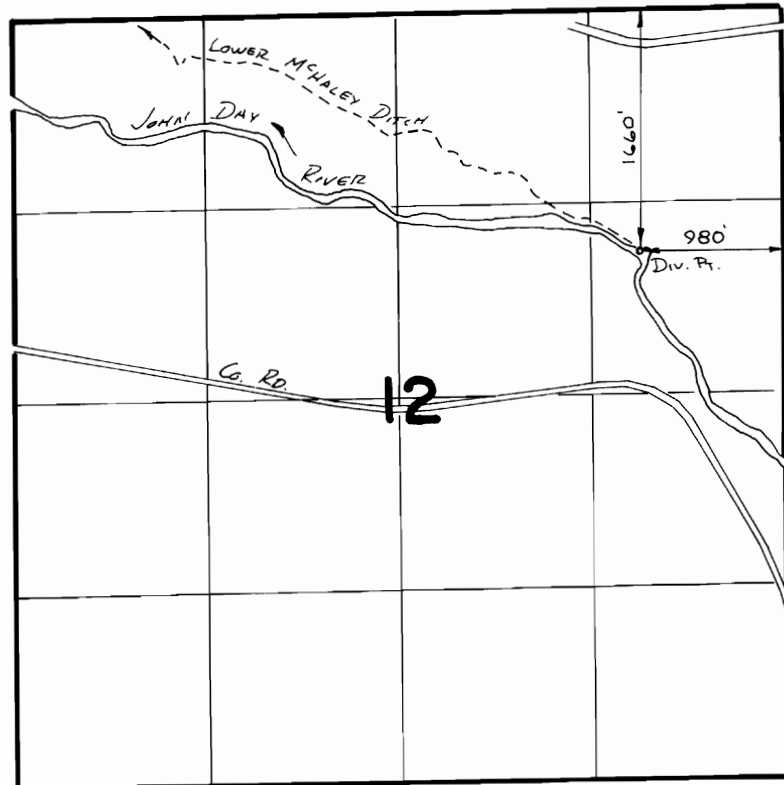

SCALE 1" = 1320'

FINAL PROOF SURVEY
UNDER

TRANSFER 4791
IN NAME OF

.....**JOHN**.....**FORREST**.....

Surveyed ..3..19..... 19.86., by *b. Tall*.....