

Tumala Creek Trch
T-4795

21⁵ ac C-31410
11² ac C-26508

250

336

290

368

60

298

210

198

320

318

366

200

380

385

322

154

27

26

324

391

370

318

400

400

334

379

341

362

361

375

240

268

02

388

351

231

08

190

64

344

330

128

197

120

Tumala Creek Trch
T-4795

250

313

343

33

243

68

236

47

34

35

392

376

11

07

360

dry rye

dry rye

dry rye

dry rye

dry rye

298

54

325

COLUMBIA

332

190

dry rye

steep and rocky

dry rye

sage

40

sage

dry rye

dry rye

dry rye

111

3



T-4795

Col. Sou. Canals

H. K. Donnelly Sept. 1909
 med Sept 6 1909
 Lewis - State Engineer.

FROM OFFICE OF THE STATE ENGINEER, SALEM, OREGON

Tumalo Creek Adjudication

T-4795

SEC 33


TWP 16S

RANGE 11E WM

PRIMARY
Cert. #26050 - 19.0
Oct. 29, 1913

SUPPLEMENTAL
Cert. #31412 - 19.0
1905

N
↑
↓
S

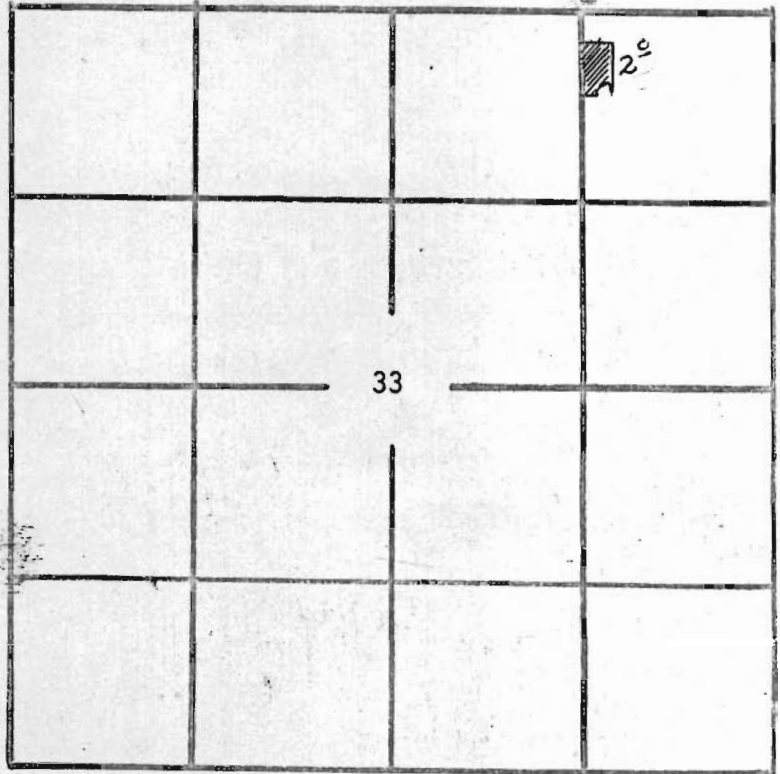

TRANSFERED FROM: NE NE SEC 33 TWP 16S R 11E WM

TRANSFERED TO: SEC TWP R

NOTES:

RECEIVED

DEC - 8 1976
WATER RESOURCES DEPT
SALEM, OREGON

"FROM"

T-3498