


16-11-34

T-4796

3.0 ON

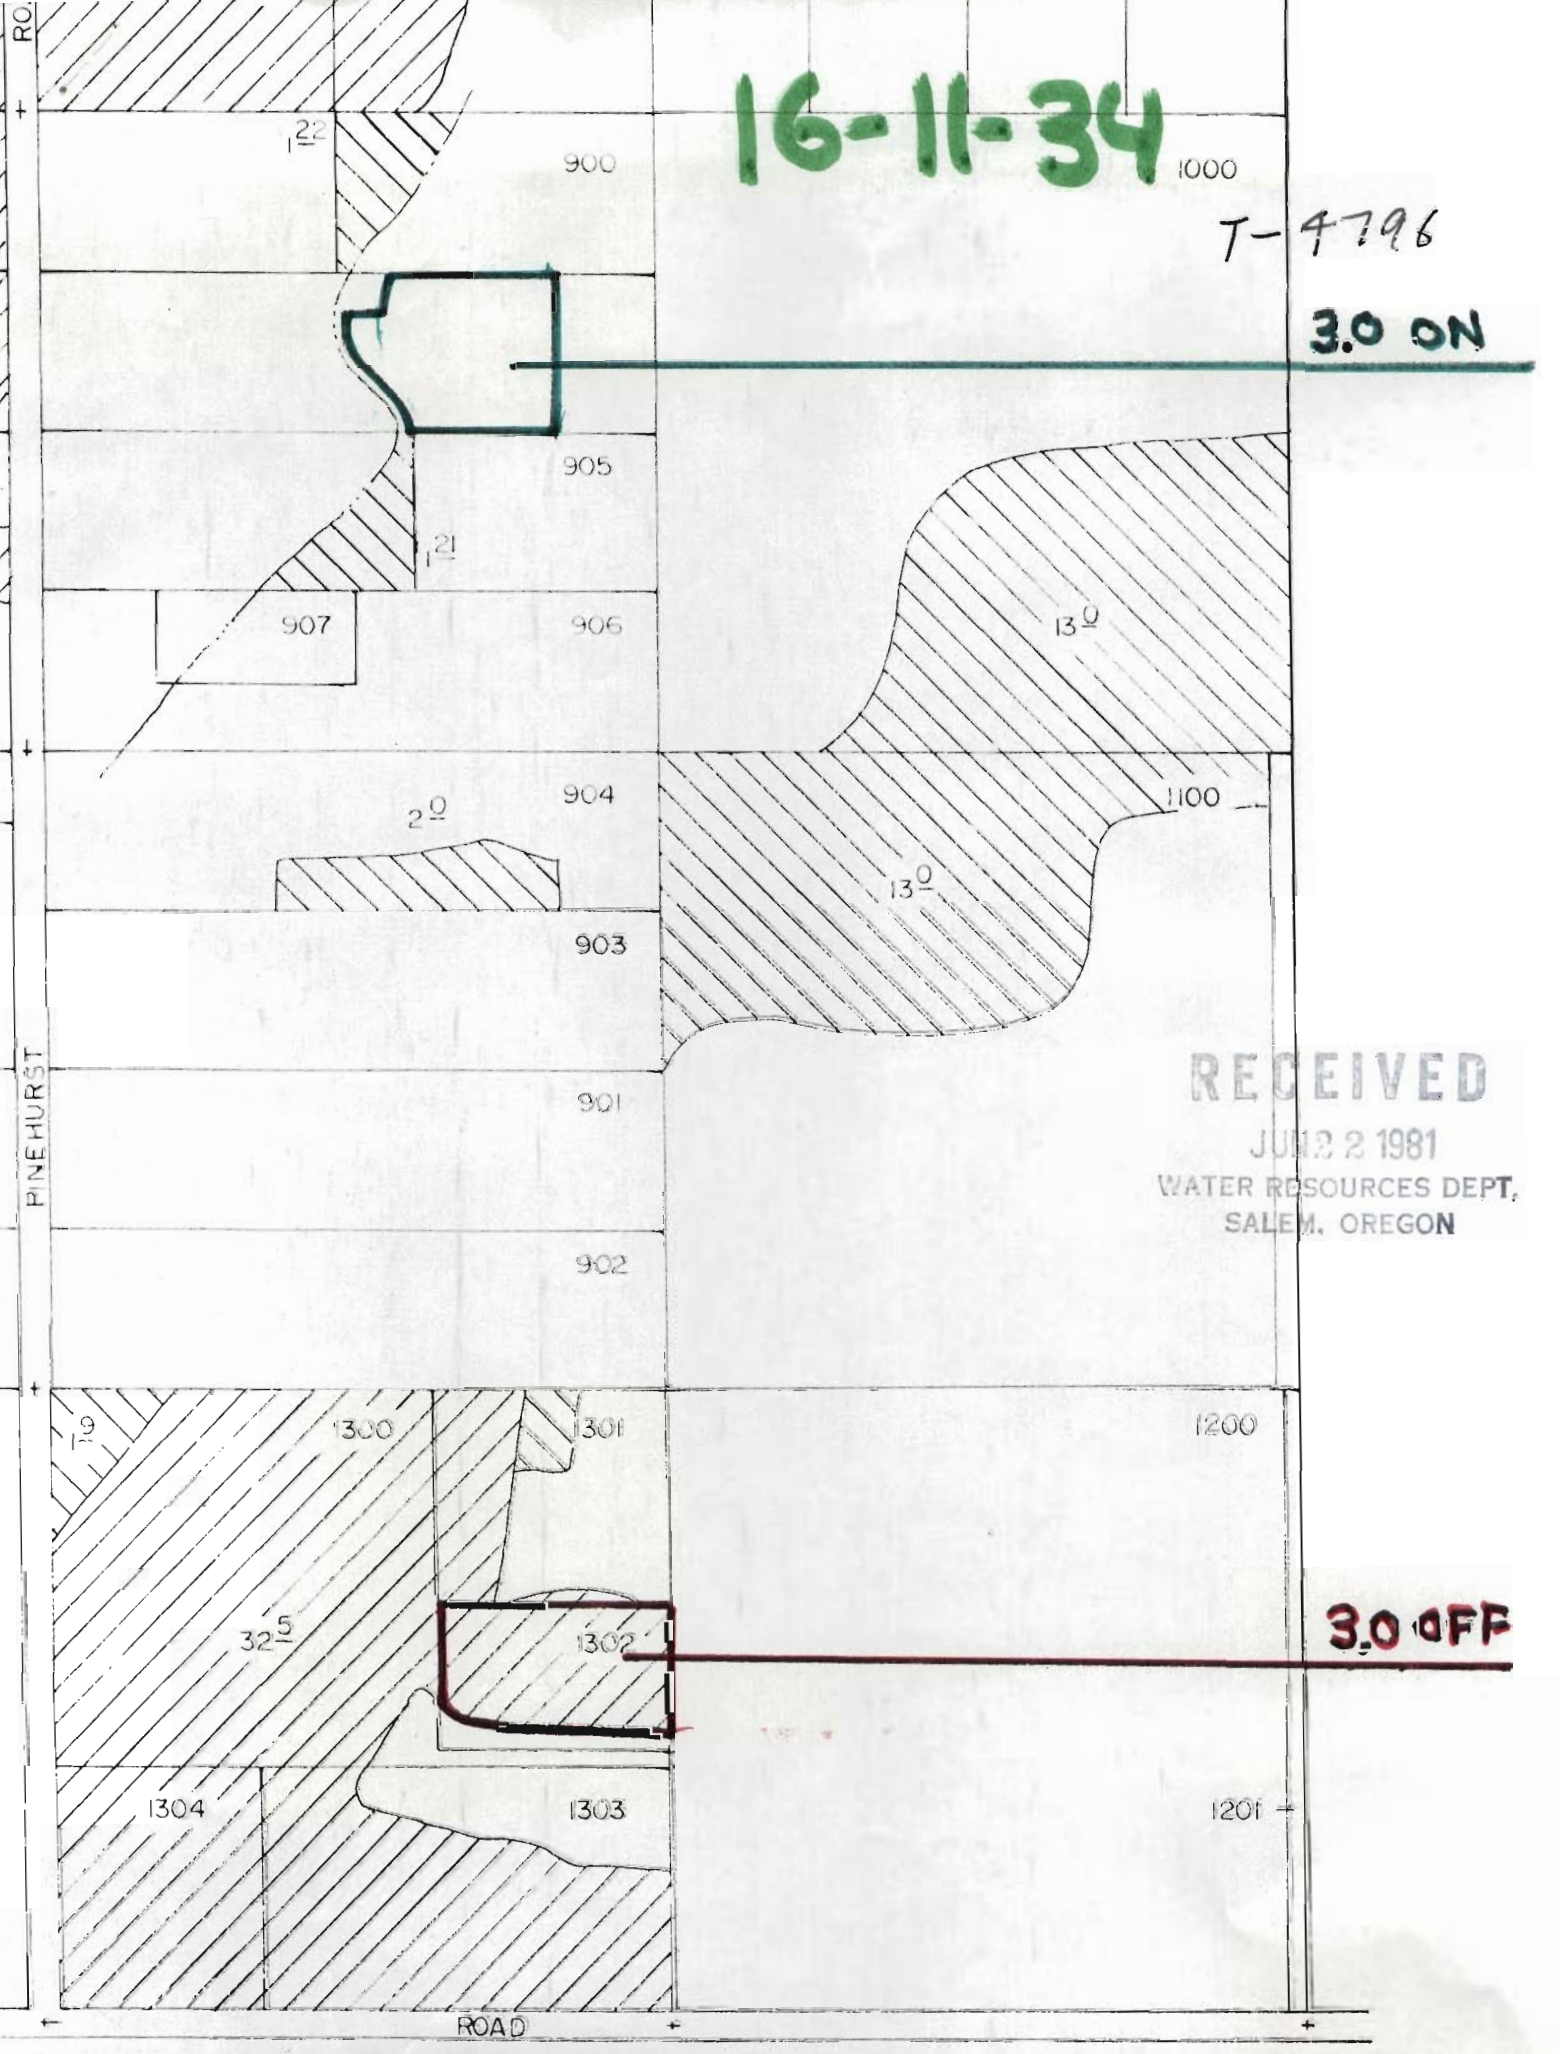


RECEIVED

JUN 2 1981

WATER RESOURCES DEPT,
SALEM, OREGON

3.0 OFF

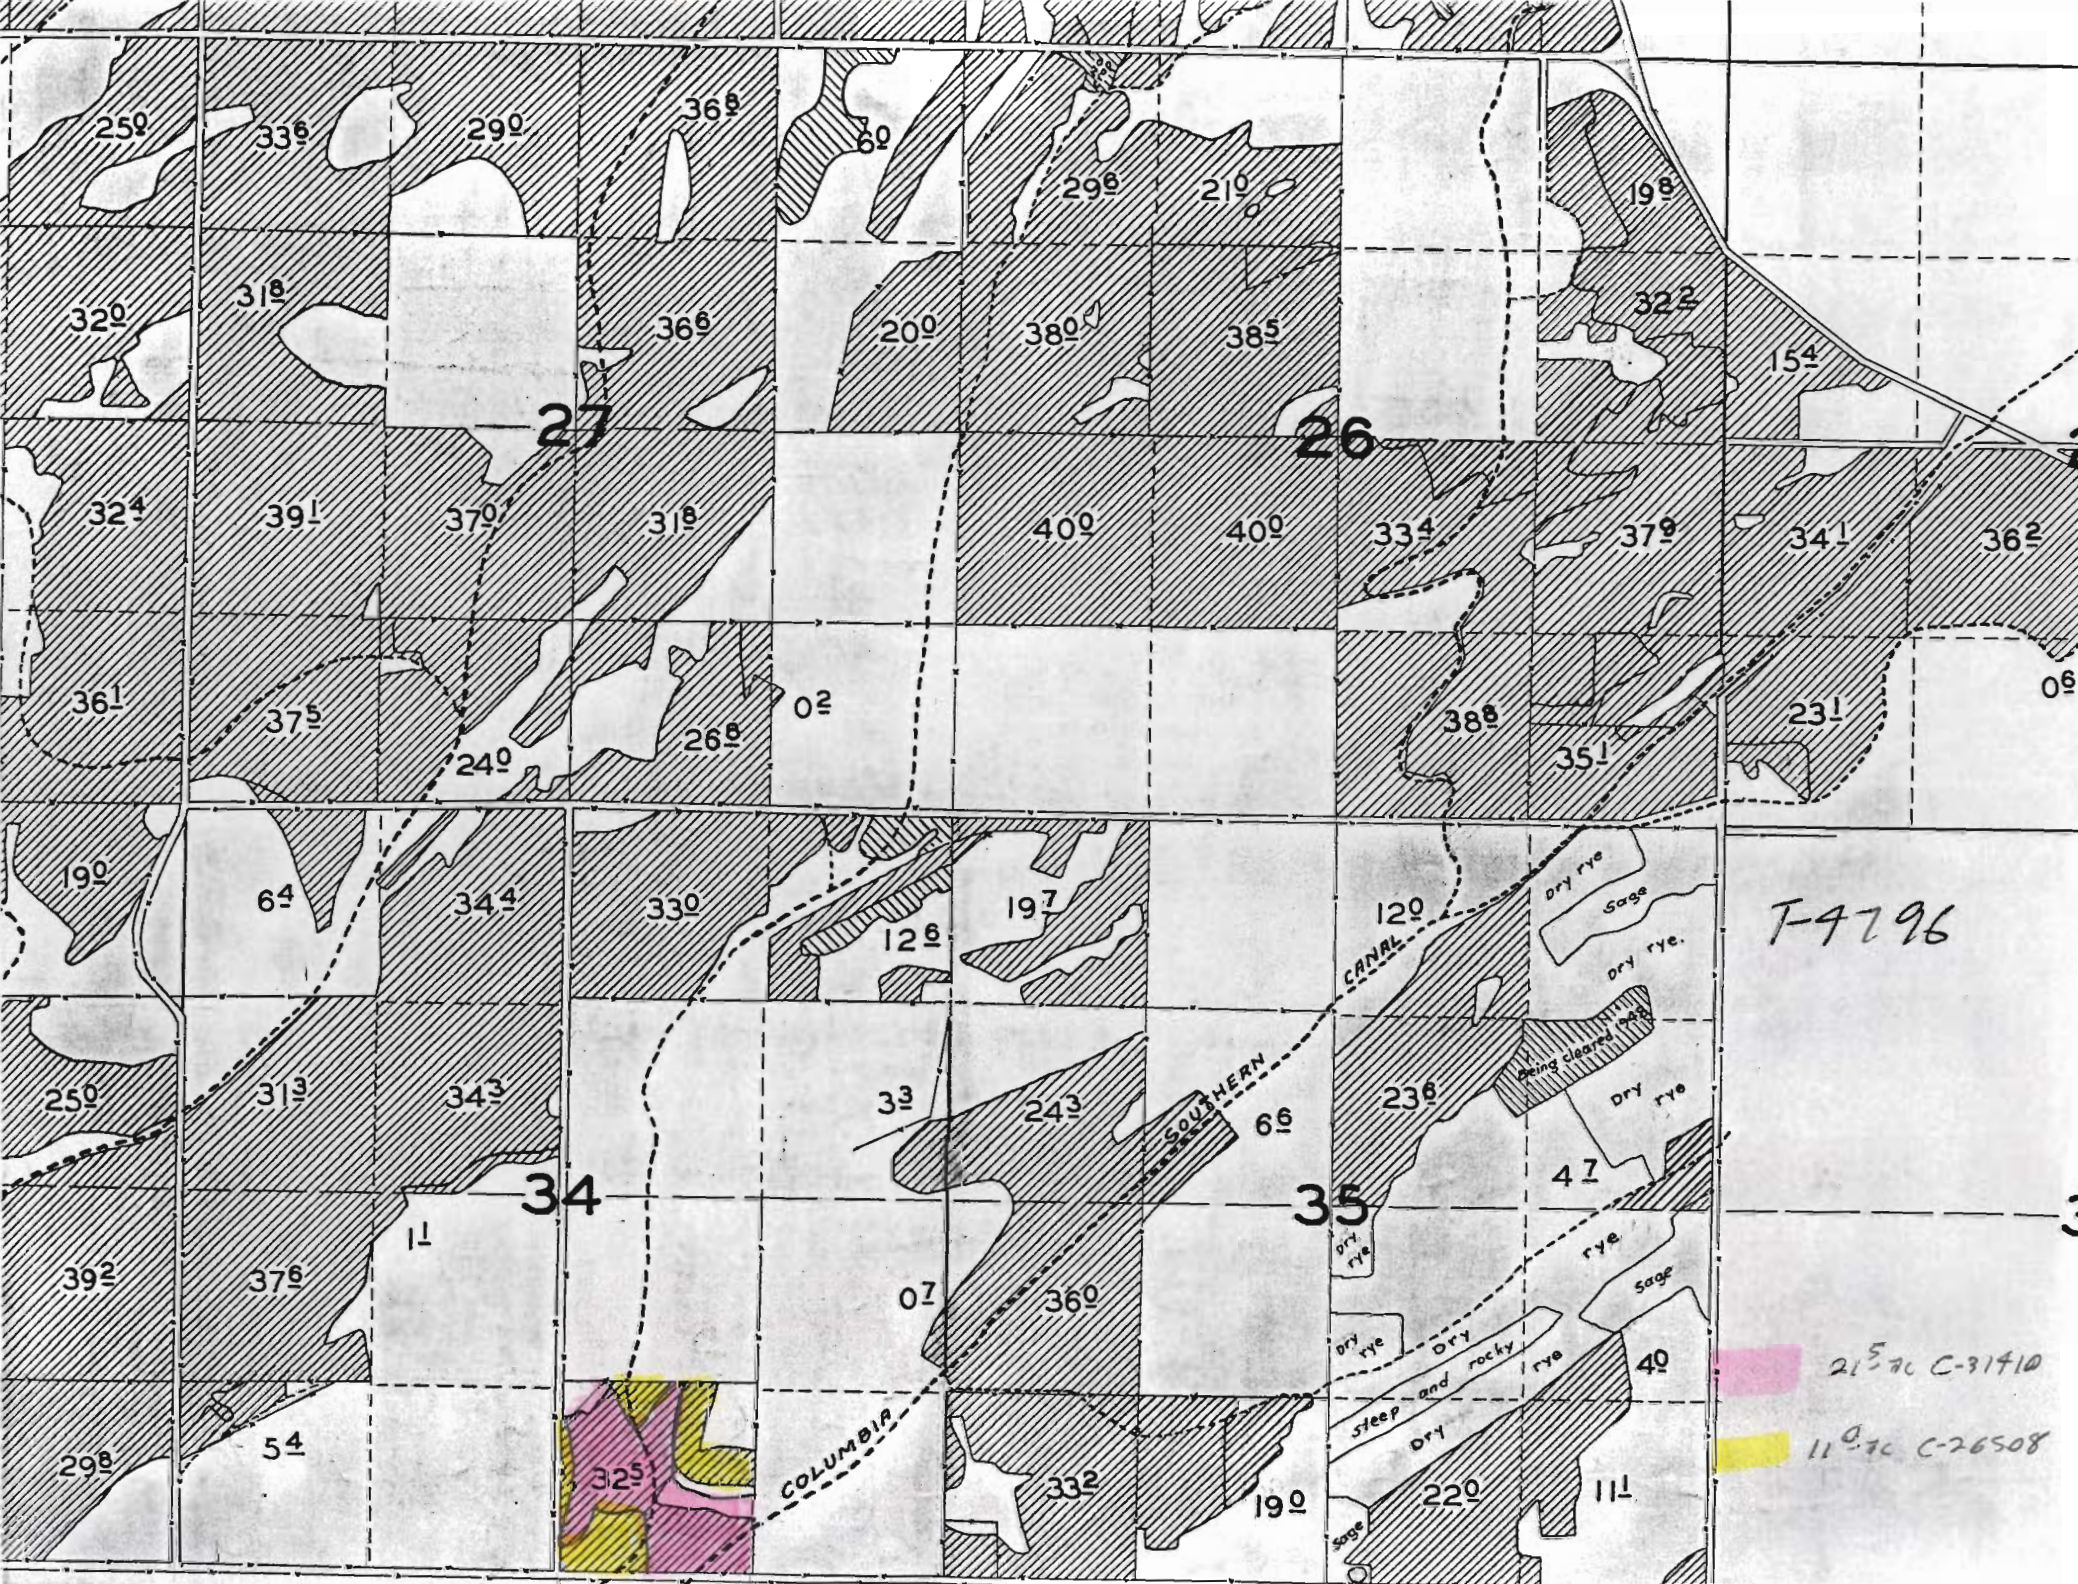

27

26

34

35

CANAL

SOUTHERN

COLUMBIA

T-9796

21570 C-31410

11070 C-26508

325

250

336

290

368

60

296

210

196

320

316

366

200

380

385

322

154

324

391

370

316

400

400

334

376

341

362

361

375

240

266

02

386

351

231

06

190

64

344

330

197

126

120

Dry rye

Sage

Dry rye.

being cleared

Dry rye

250

313

343

33

243

66

236

47

392

376

11

07

360

dry rye

dry rye

dry rye

dry rye

sage

dry rye

dry rye

dry rye

dry rye

sage

298

54

325

332

332

190

220

111

40



H. K. Donnelly Sept. 1909
 ed Sept. 6, 1909
 Lewis - State Engineer.

FROM OFFICE OF THE STATE ENGINEER, SALEM, OREGON

Tumalo Creek Adjudication