
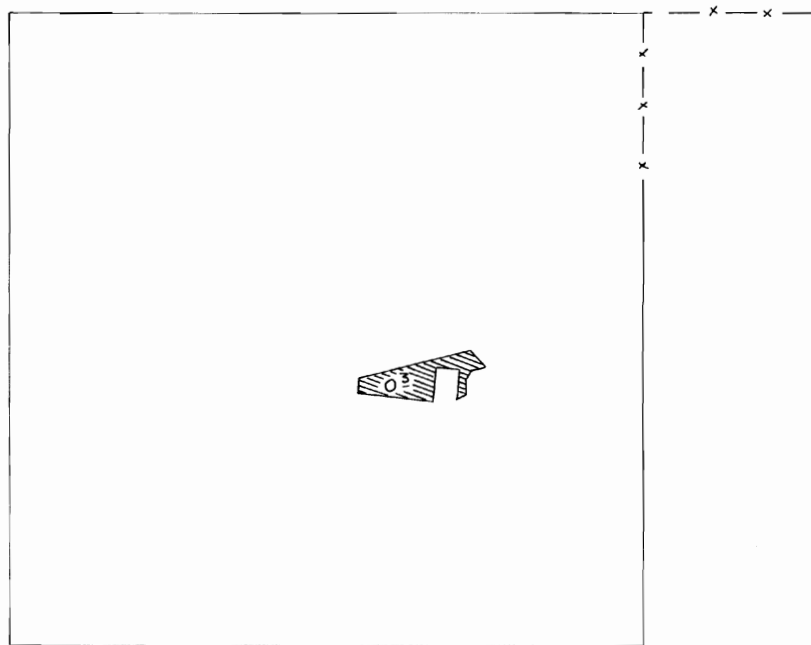


T. 4S., R. 12E., W. M.

SECTION 4 SE1/4 NW1/4

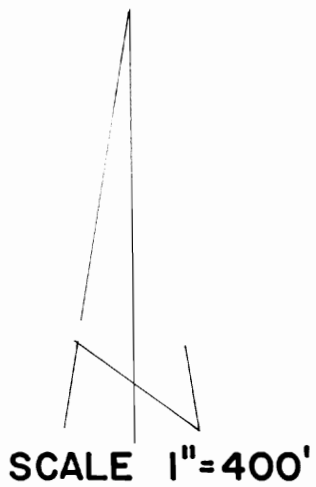

**FINAL PROOF SURVEY**  
UNDER

**TRANSFER 4800**  
IN NAME OF

.....**MAYNARD KINZEY**.....

Surveyed 10:18..... 19.88, by *V.L. Church*.....