


T. 20S., R. 42E., W.M.

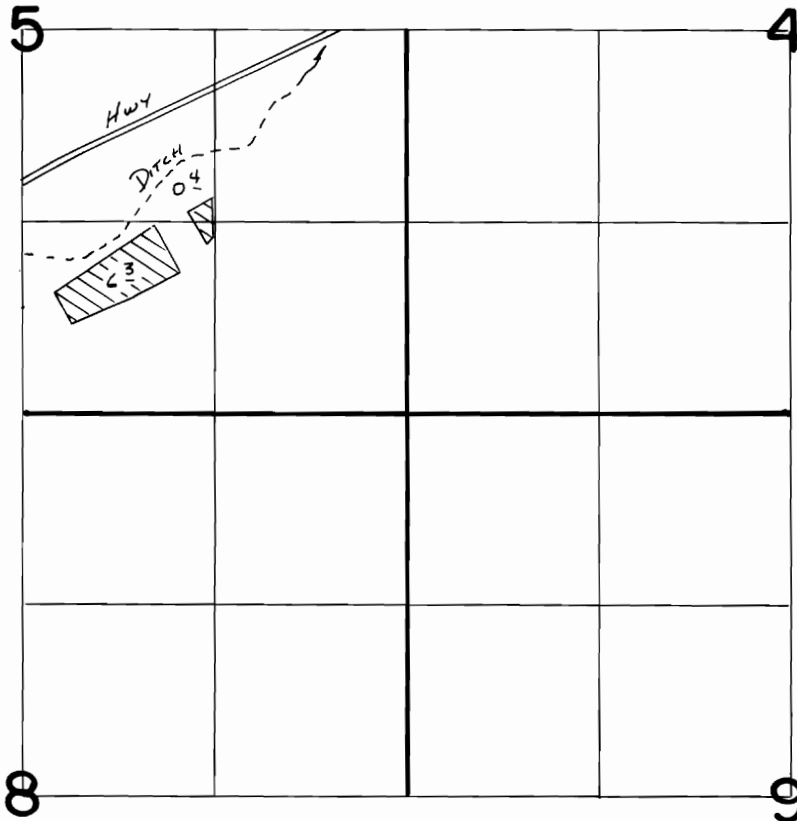

SCALE 1" = 1320'

FINAL PROOF SURVEY
UNDER

TRANSFER 4820
IN NAME OF

.....**ROBERT O. KNUDSON**.....

Surveyed 10-12..... 1988, by *V.L. Church*.....