


RECEIVED


WATER RESOURCES DEPT
SALEM, OREGON

T-4824


CROOK COUNTY CROOK

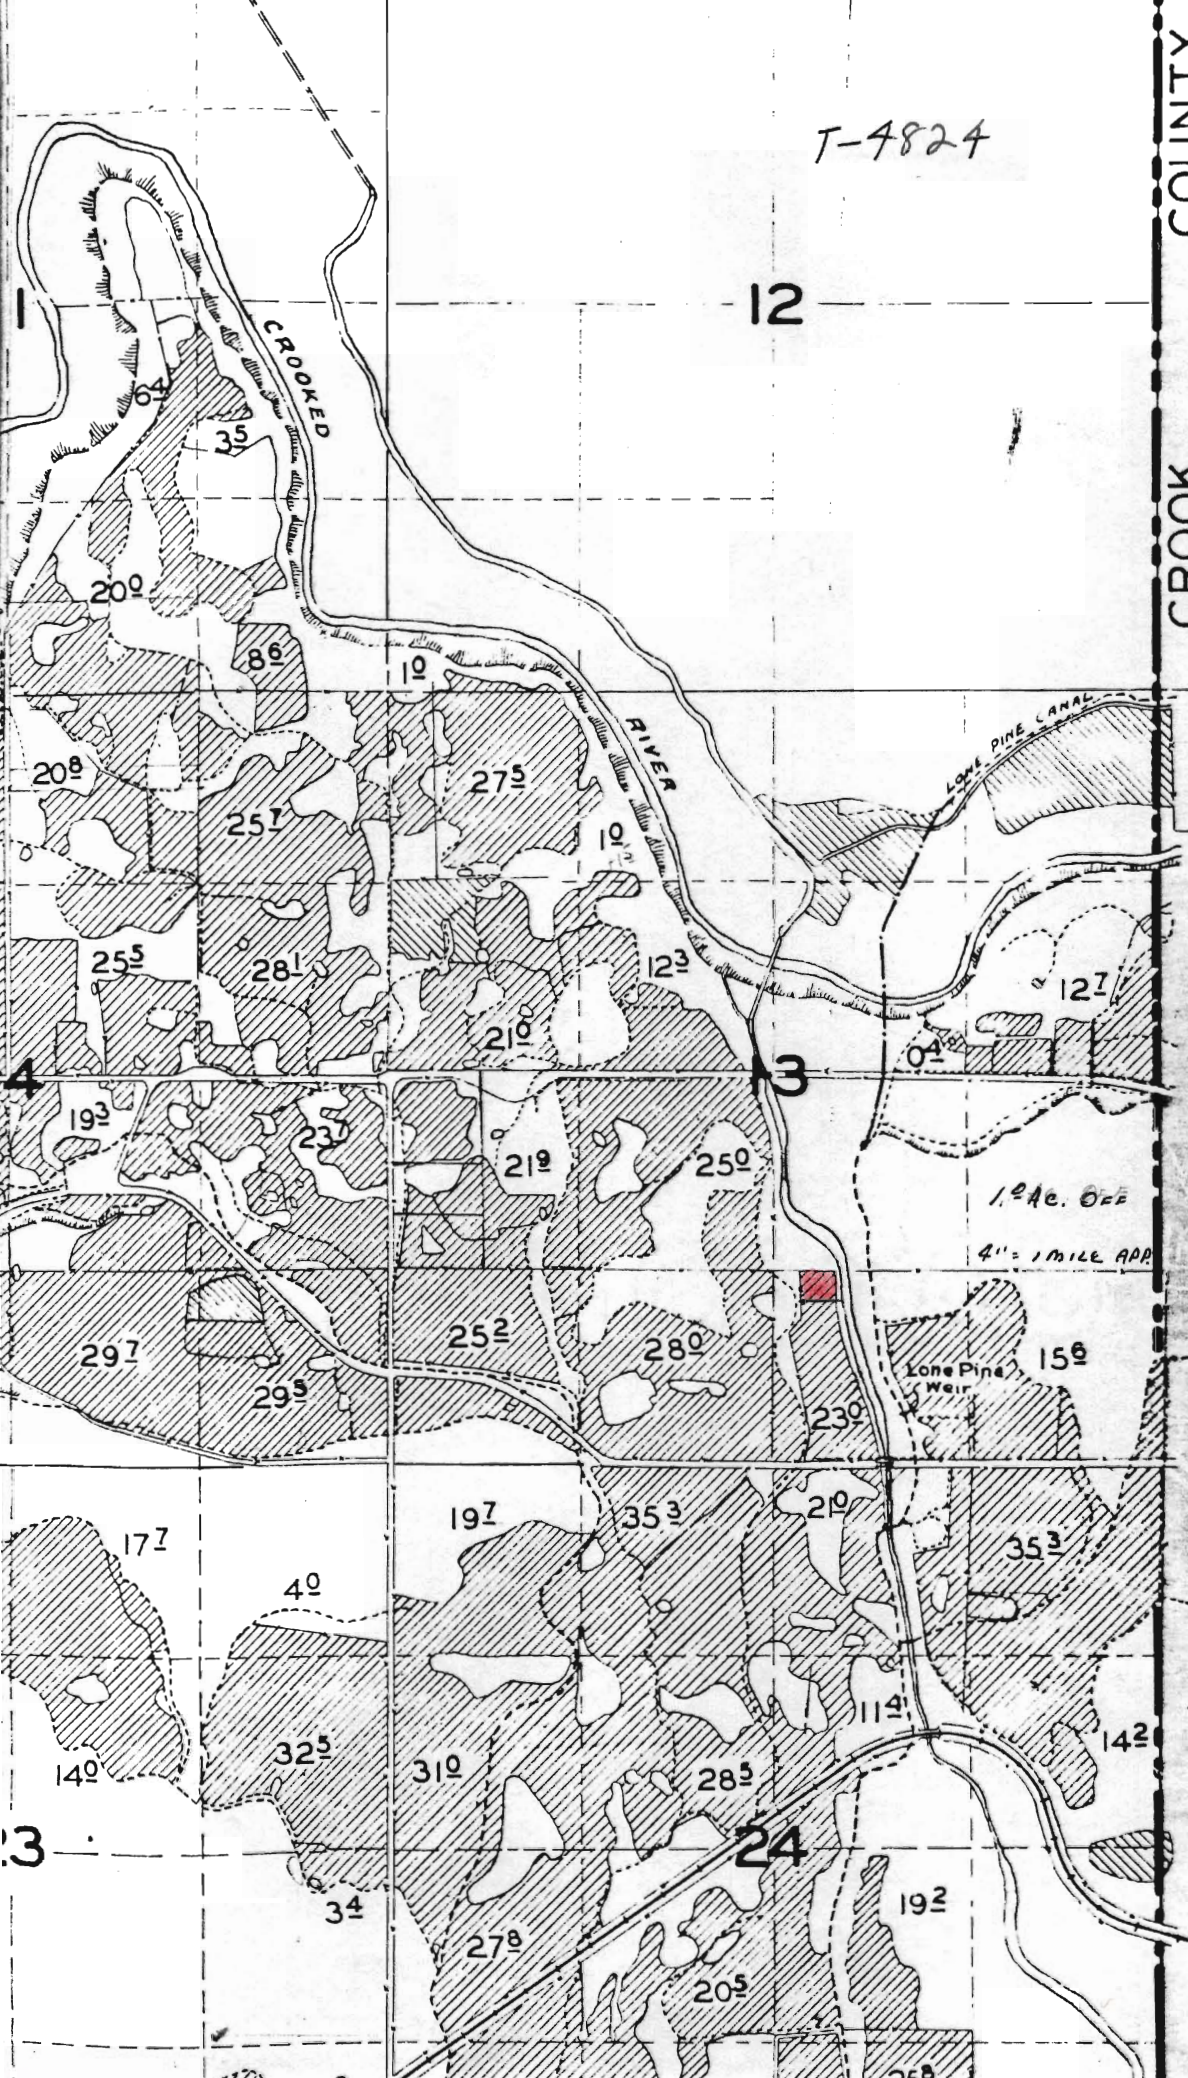

T-4824

CROOK COUNTY

CROOK COUNTY

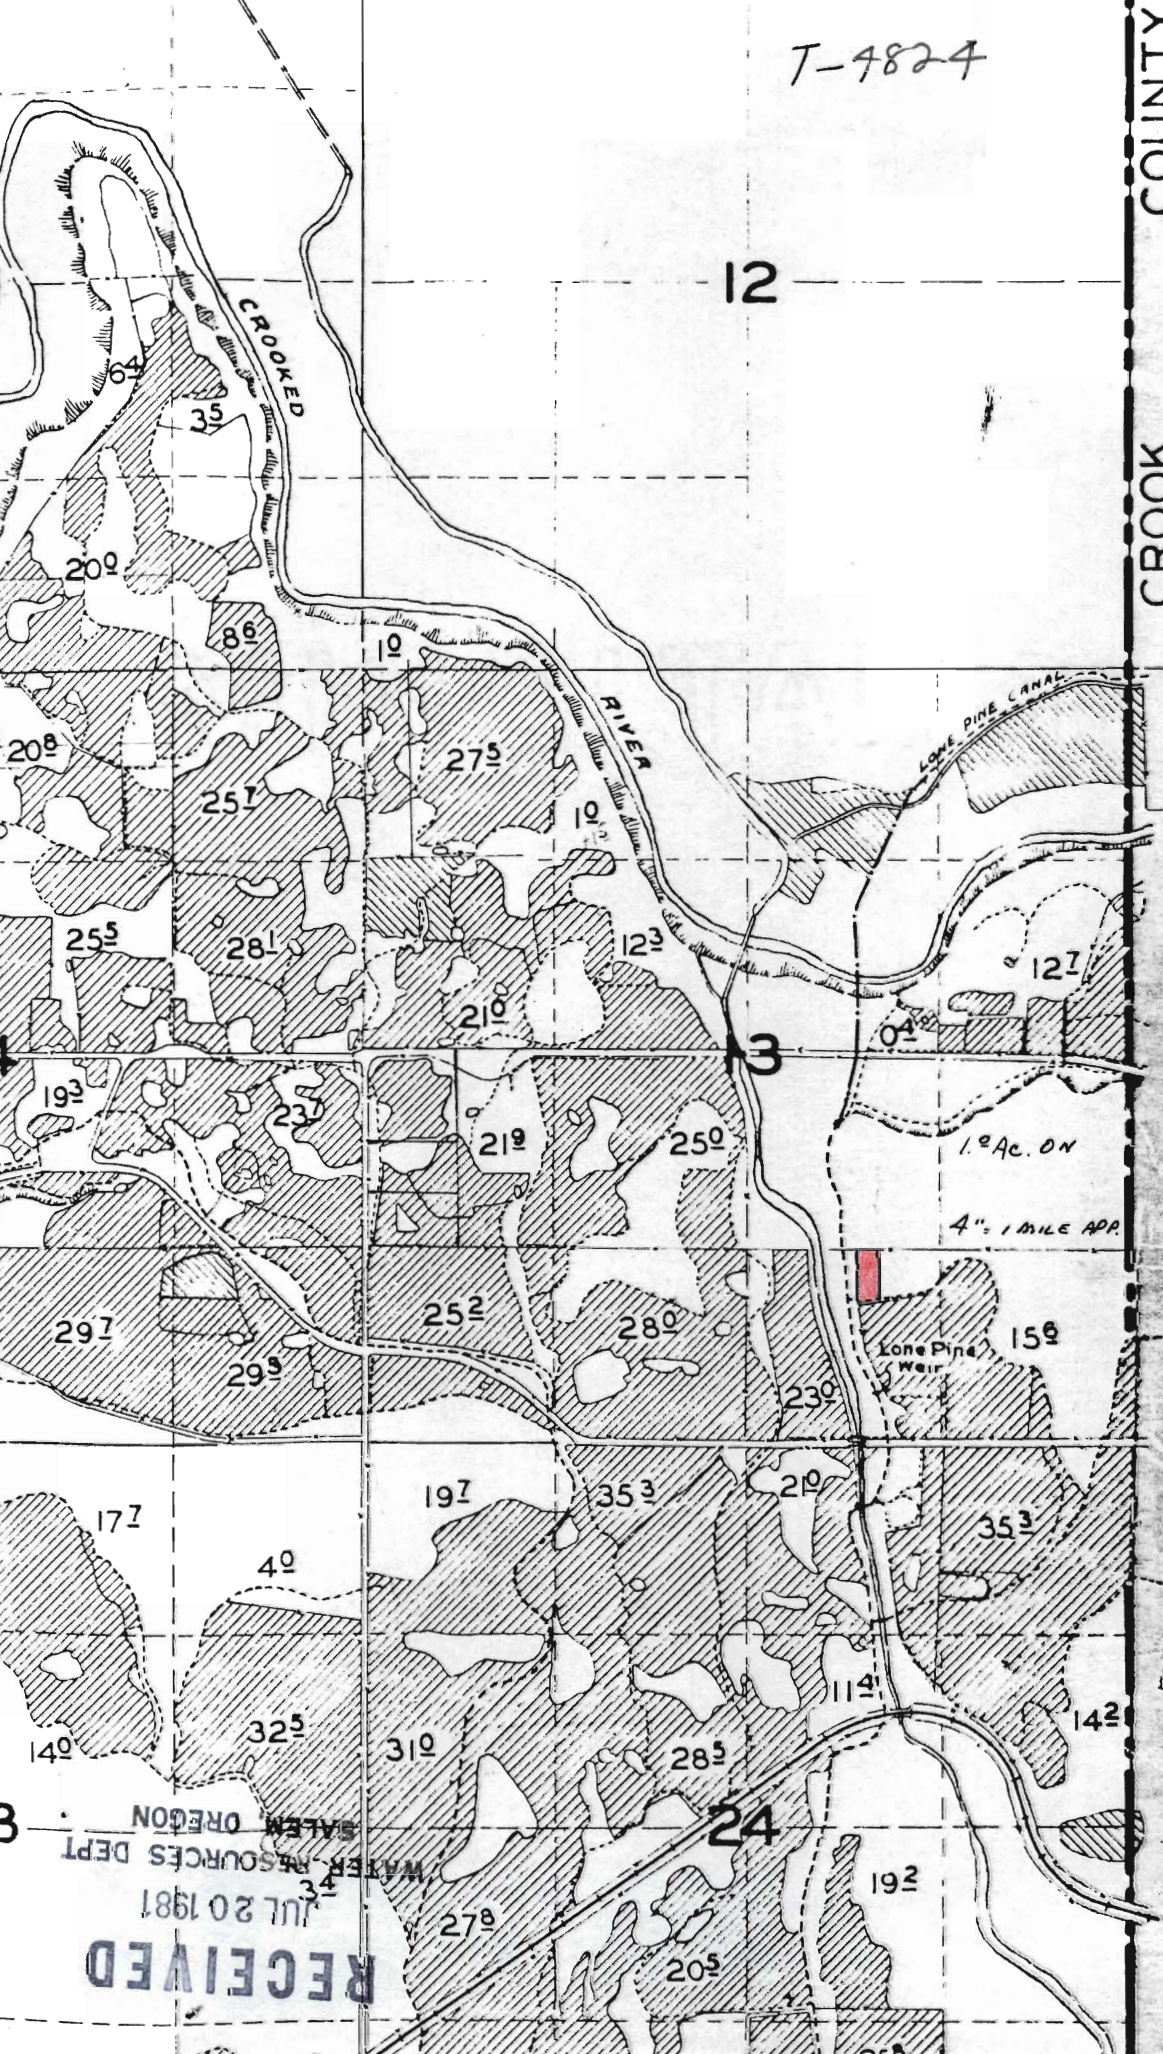

RECEIVED

JUL 20 1981

WATER RESOURCES DEPT. SALEM OREGON