

RECEIVED


JUL 20 1981

WATER RESOURCES DEPT
SALEM, OREGON

T-4825

COUNTY

CROOK

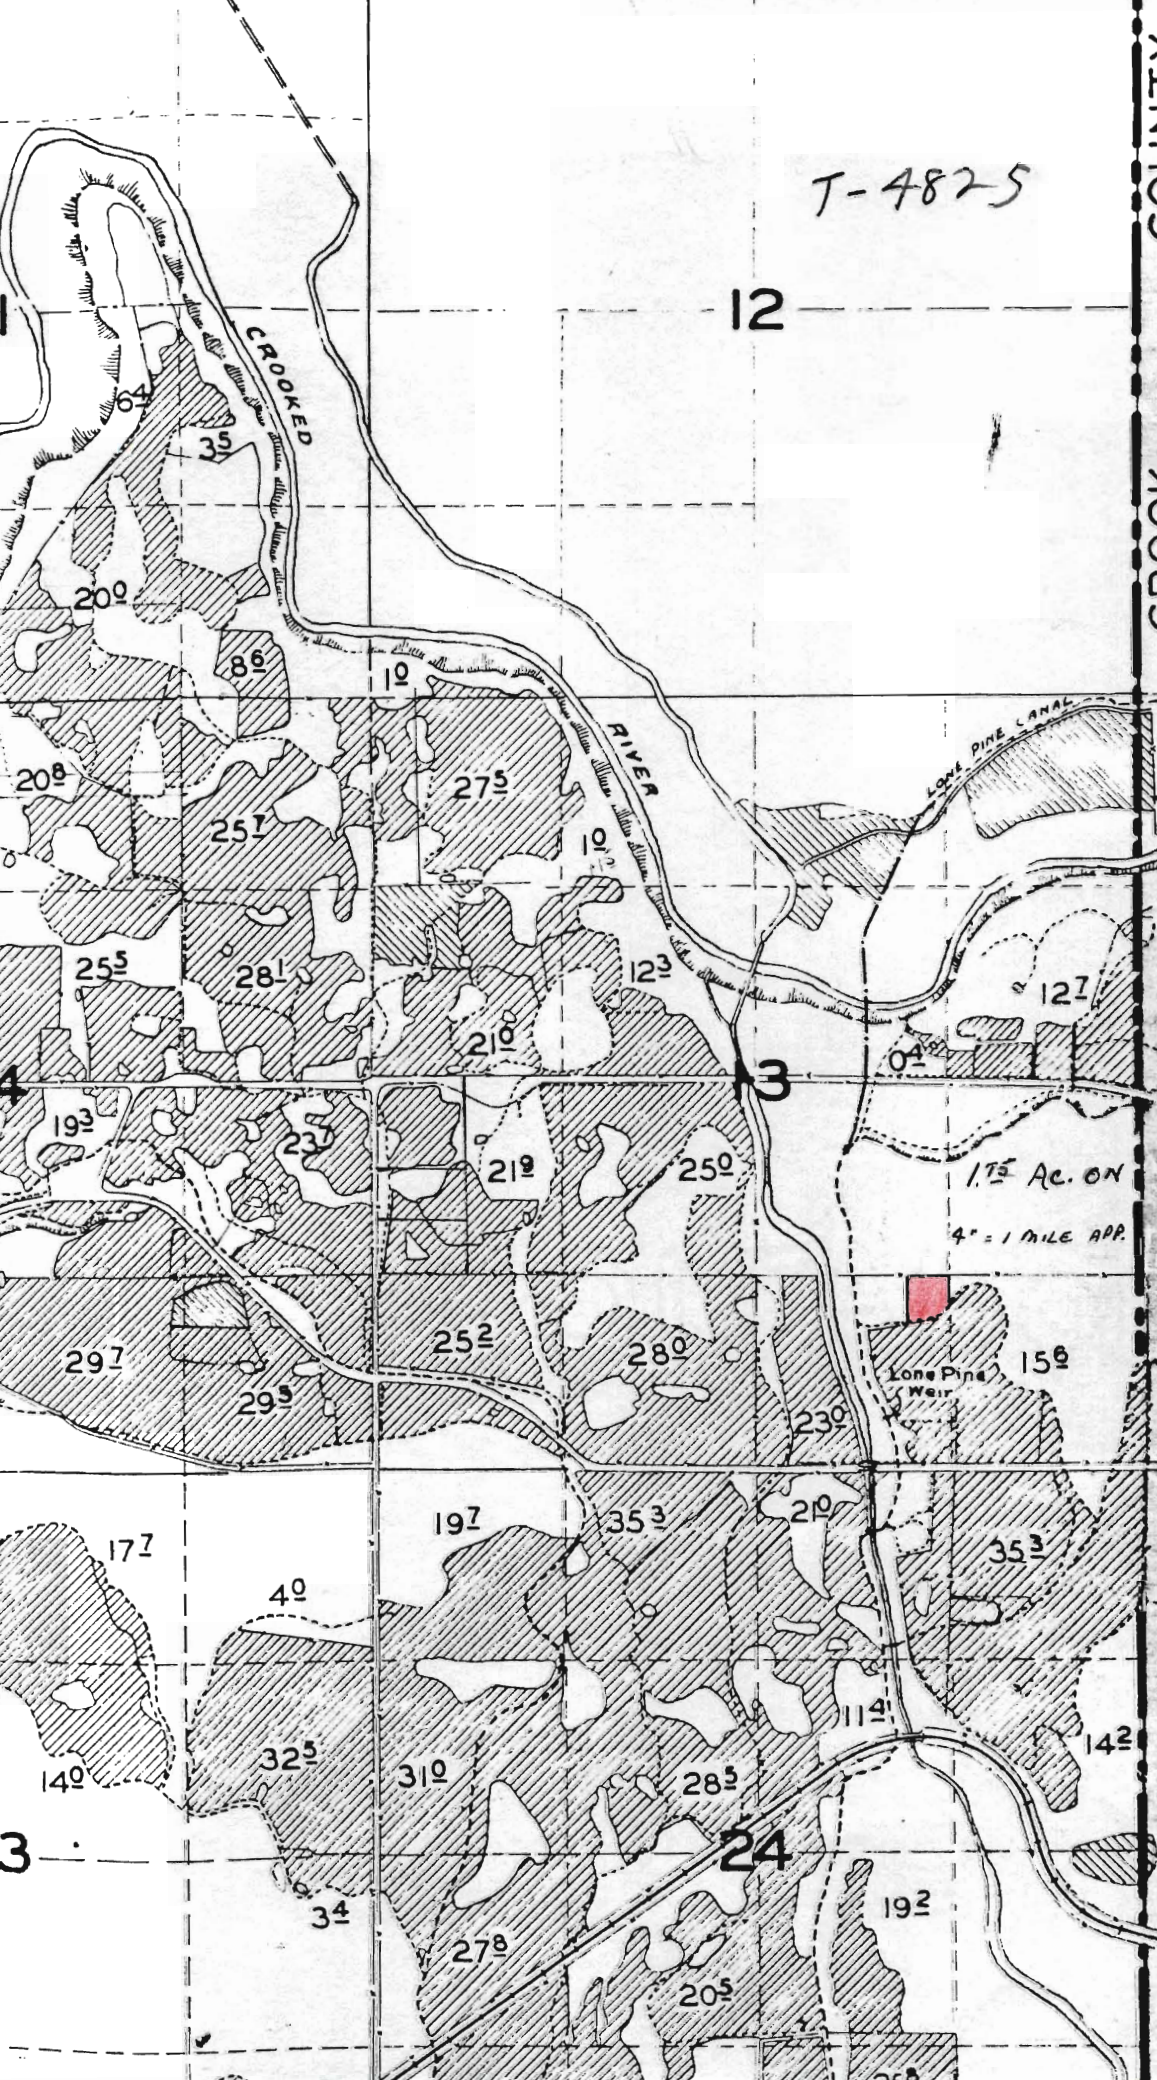

1.75 AC. ON
4" = 1 MILE APP.

Long Pine Weir

1

12

208

257

275

10

RIVER

LONG PINE CANAL

4

193

281

210

123

3

127

04

219

250

297

295

252

280

230

156

Long Pine Weir

177

197

353

20

353

3

140

325

310

285

114

142

24

34

278

205

192

RECEIVED

JUL 20 1981

WATER RESOURCES DEPT
SALEM, OREGON

T-4875

CROOK COUNTY
CROOK

