


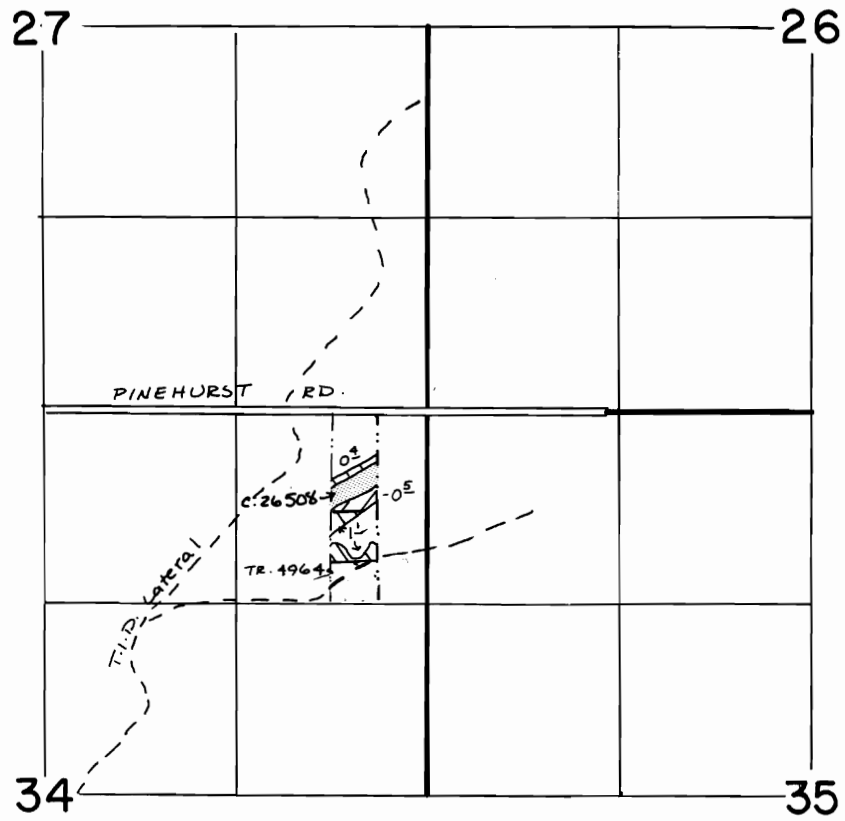

T.16S., R.11E., W.M.



SCALE : 1" = 1320'

FINAL PROOF SURVEY

UNDER

Transfers 4828  & 4889 

IN NAME OF

.....RICHARD & JUDY PARTCH.....

Surveyed APRIL 9.. 19.85., by L...OLSON.....