


RECEIVED

JUL 17 1981

WATER RESOURCES DEPT.
SALEM, OREGON

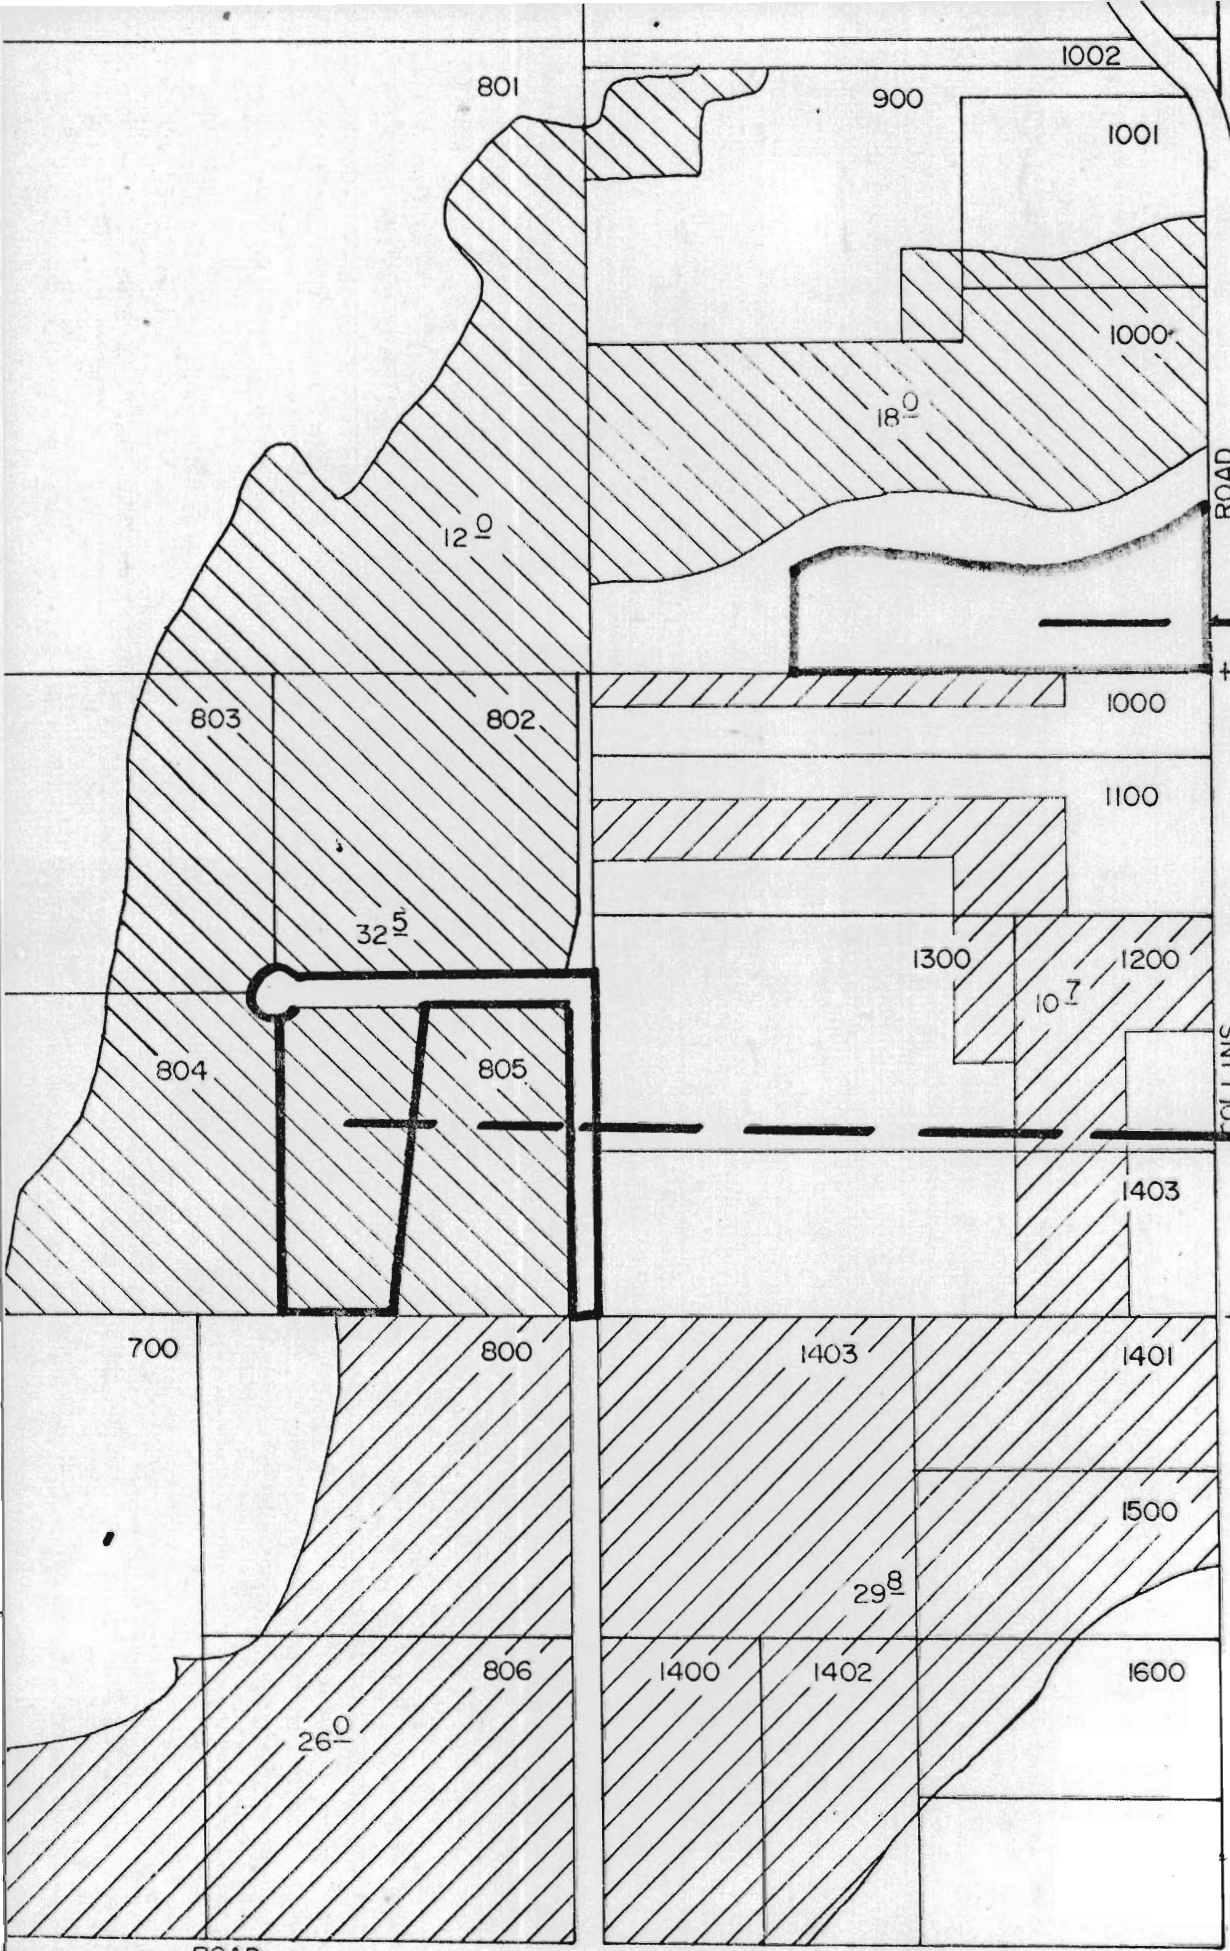

5.0 ON

5.0 OFF

16-11-33