


T.16S., R.11E., W.M.

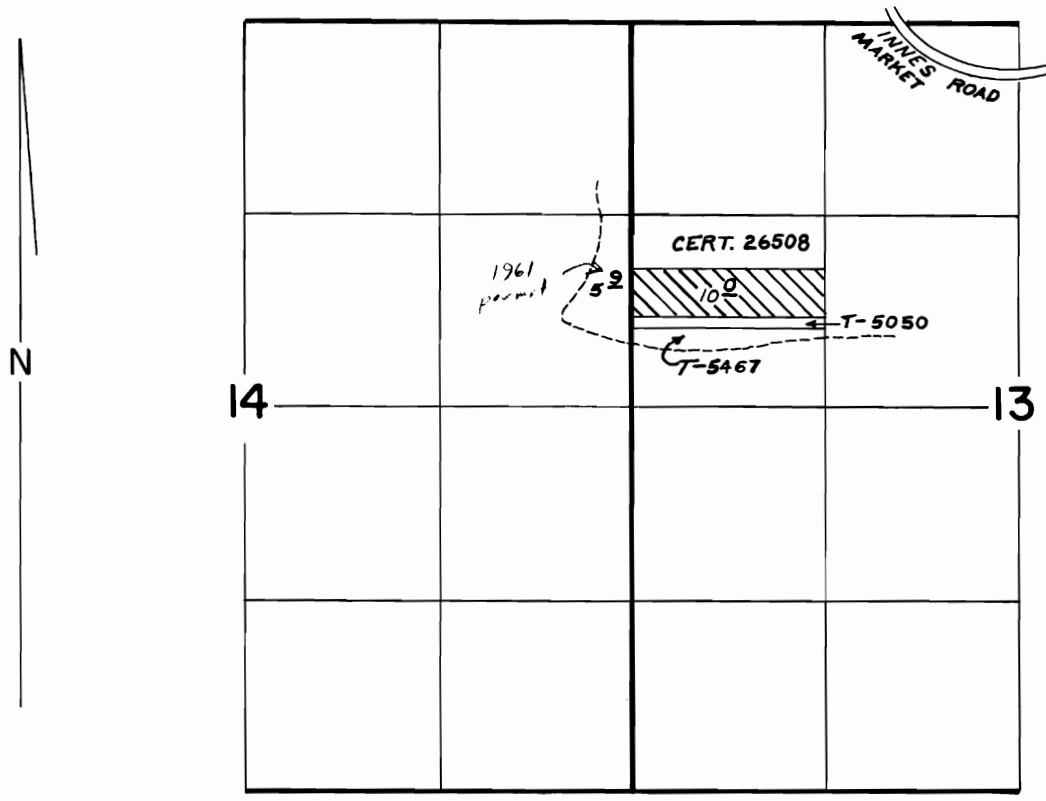

SCALE: 1" = 1320'

FINAL PROOF SURVEY UNDER

TRANSFER NO. 4832

IN NAME OF

ROBERT E. or JOYCE L. GARDNER

Surveyed MAY 25 1985, by LESLIE OLSON.