


# T.12S., R.14E., W.M.

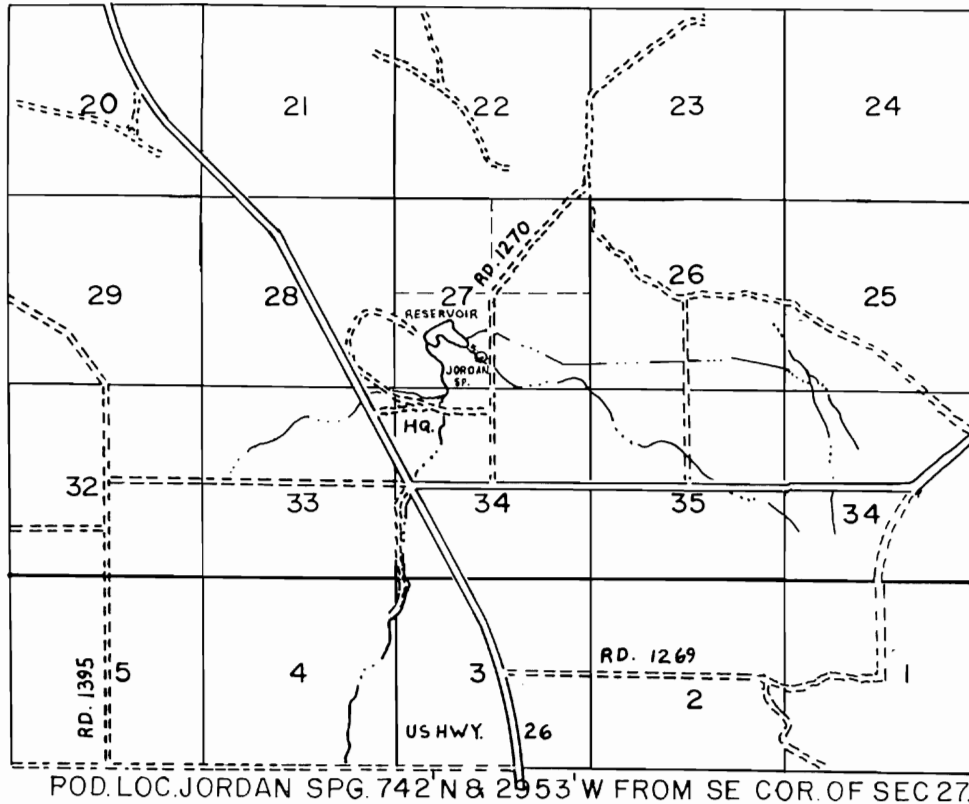

SCALE : 1" = 1 MILE

## FINAL PROOF SURVEY UNDER

TRANSFER NO. 4837

IN NAME OF

### U.S. CROOKED RIVER NATIONAL GRASSLAND

Surveyed MAY 6..... 1983., by L.H. NUNN.....