


T. 13S., R. 31E., W.M.

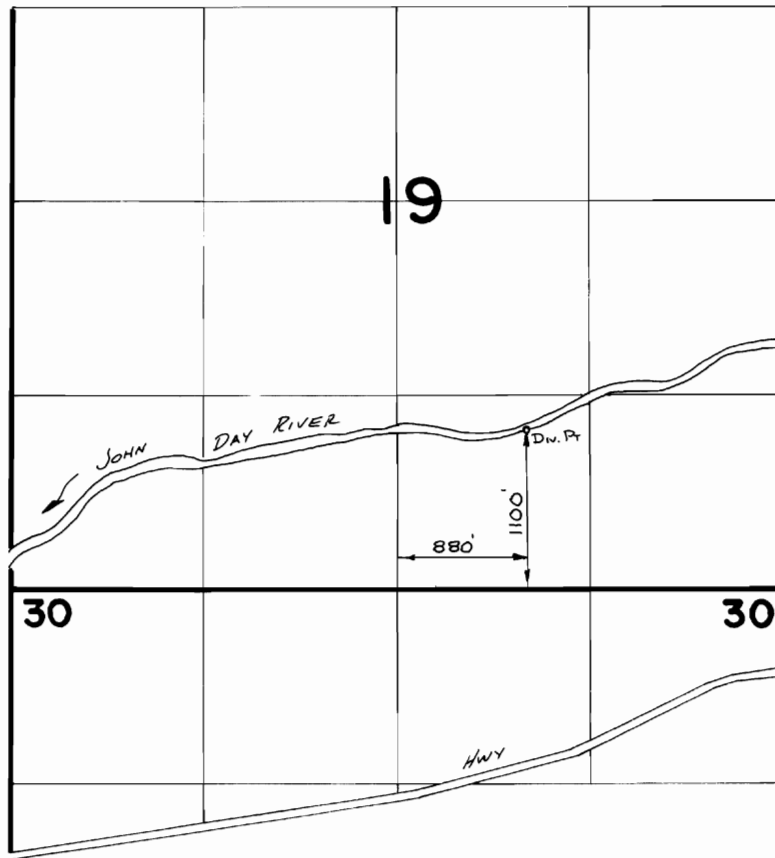

SCALE 1" = 1320'

FINAL PROOF SURVEY
UNDER

TRANSFER 4846
IN NAME OF

.....**RAMONA MORRIS**.....

Surveyed ~~3-19~~..... 19~~86~~., by *V.L. Church*.....