


T. 32 S., R. 6 W., W. M.

SECTION 33

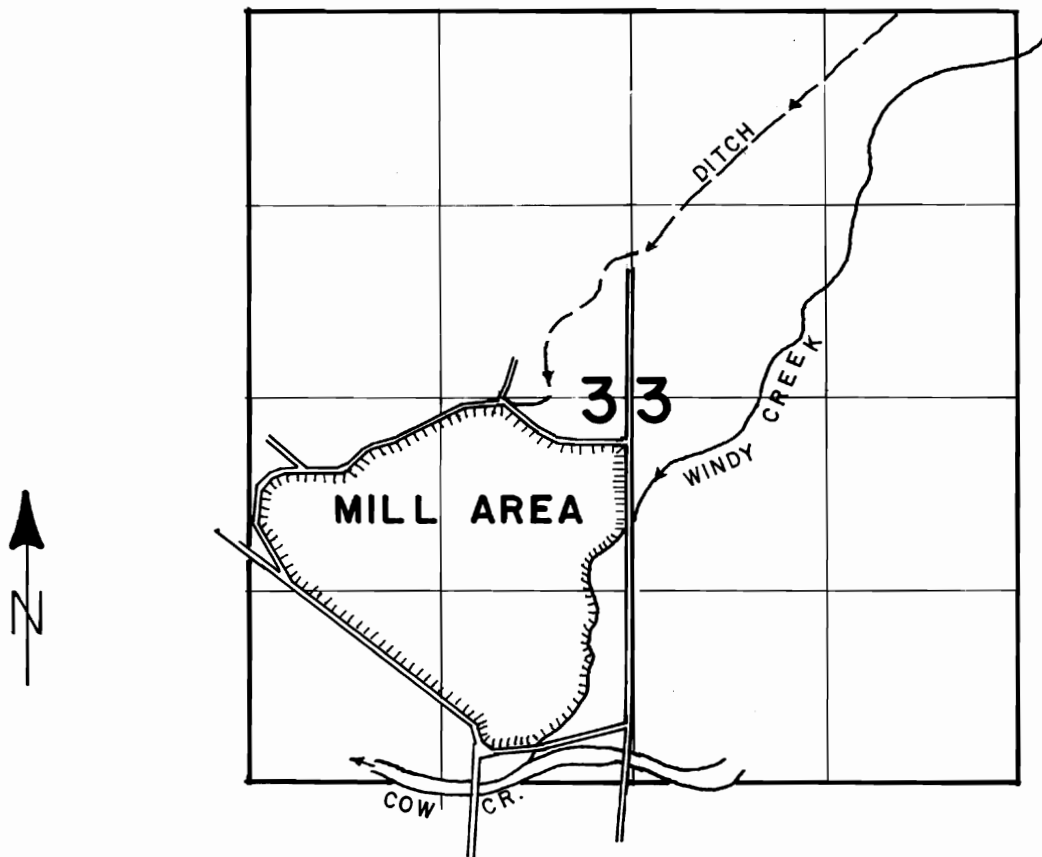

SCALE: 4" = 1 MILE

FINAL PROOF SURVEY
UNDER

TRANSFER NUMBERS: 4850, 4851 & 4852
IN NAME OF
ELK LAKE TIMBER CO., d.b.a.
GREGORY TIMBER RESOURCES, INC.

Surveyed JUNE 4 1987, by J. M. SCHMORDE