
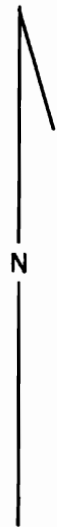


T.16S., R.12E., W.M.

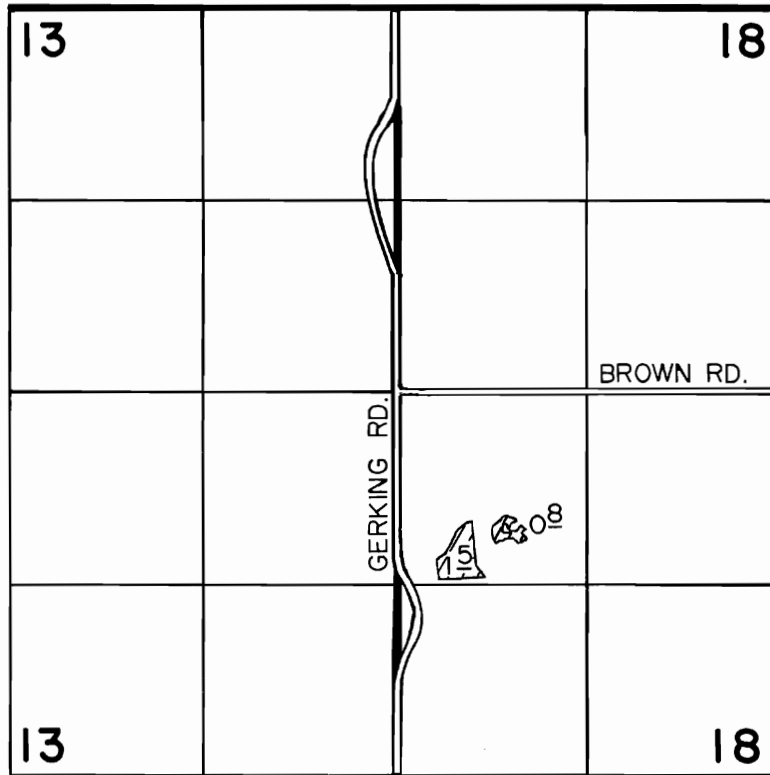

SCALE : 1" = 1320

FINAL PROOF SURVEY

UNDER

TRANSFER NO. 4854

IN NAME OF

LOUISE BARTLETT

Surveyed OCT. 17... 1985., by LESLIE OLSON...