


T-4856

6.2 OFF

16-12-17

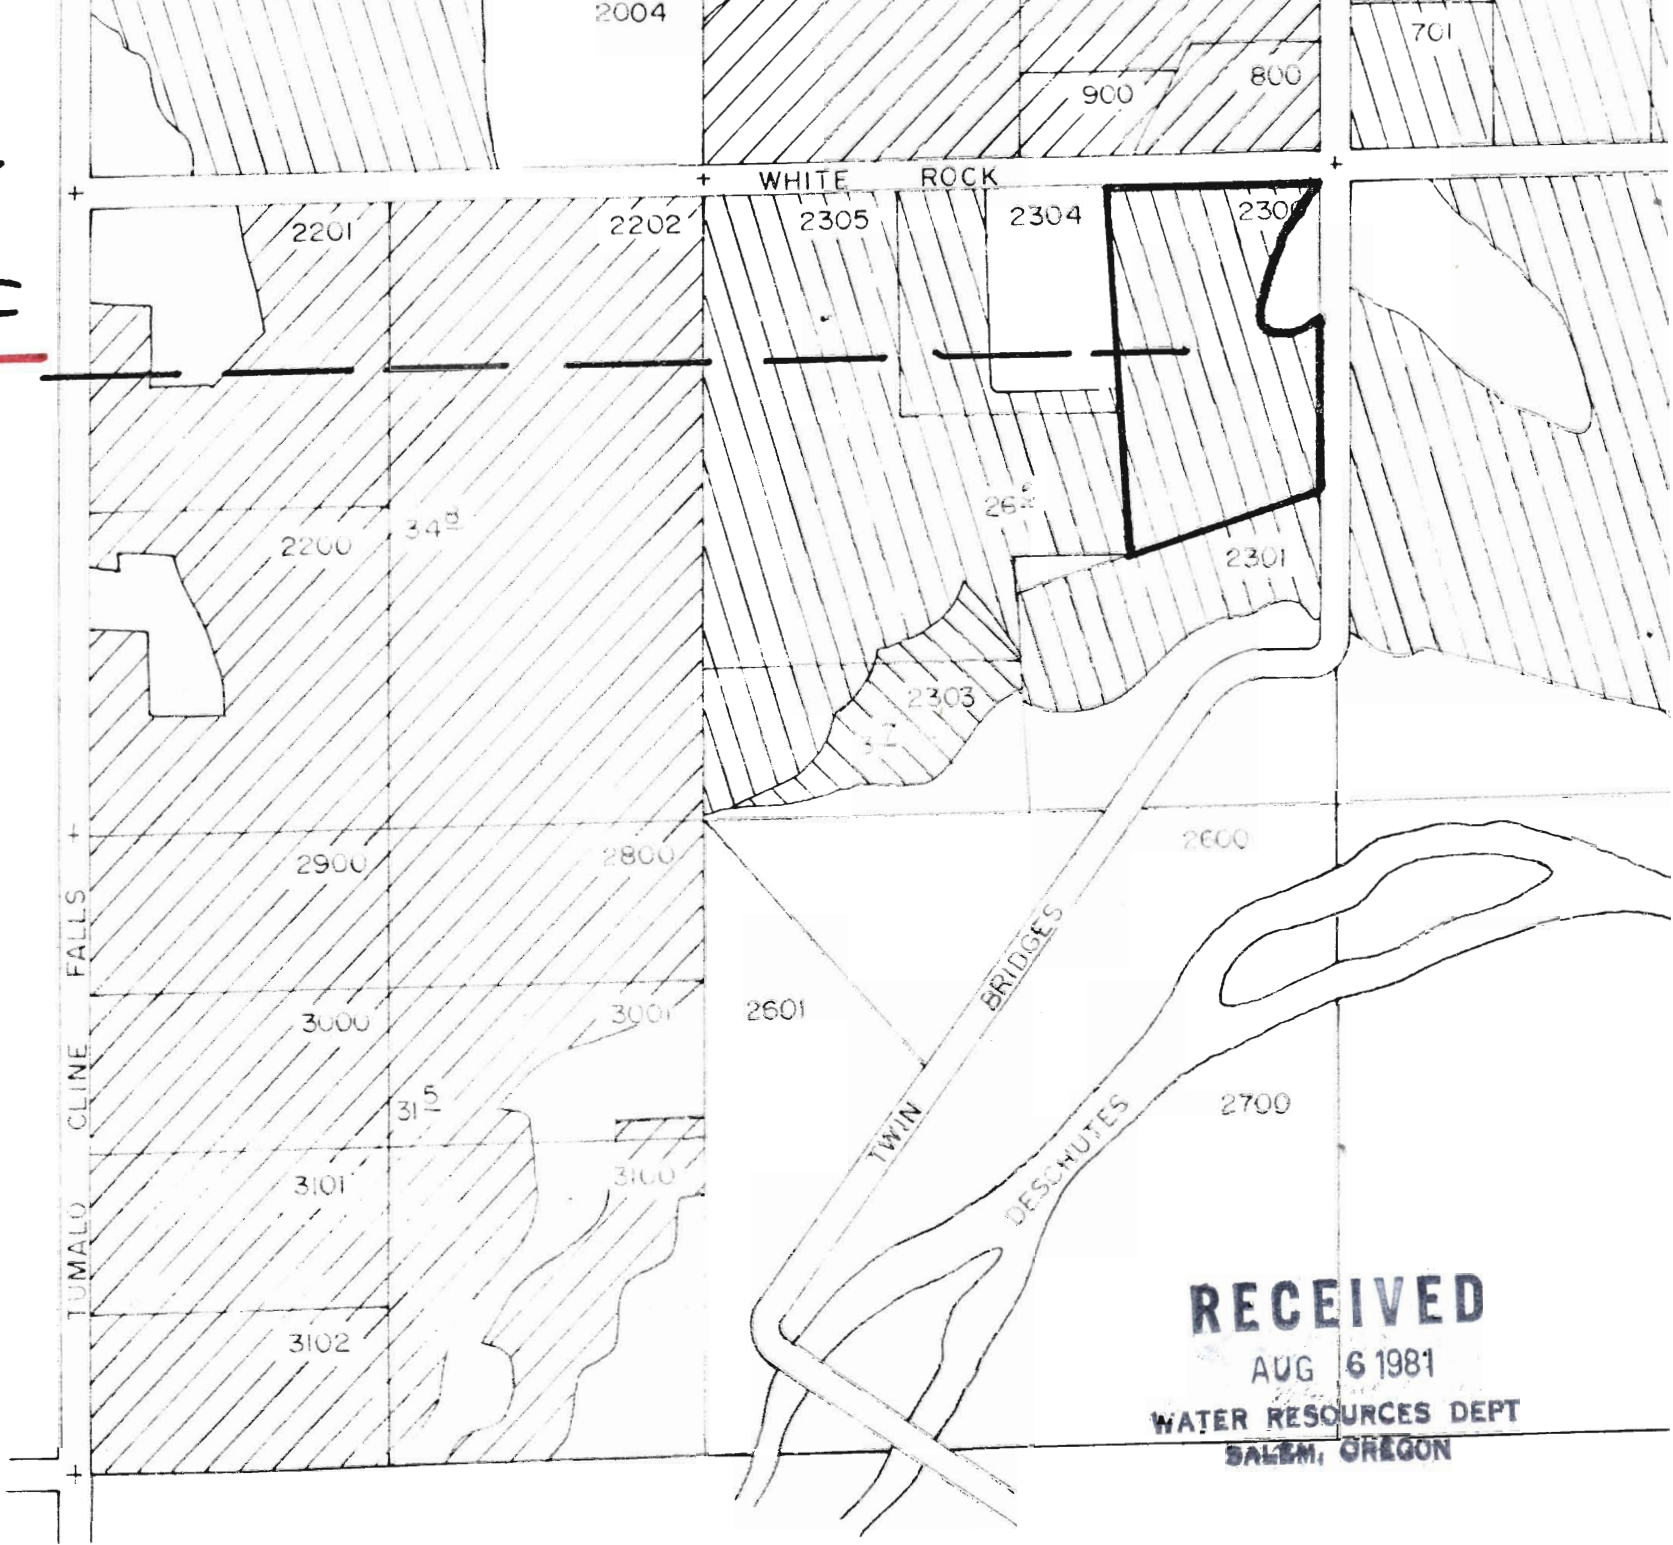

RECEIVED
 AUG 6 1981
 WATER RESOURCES DEPT
 SALEM, OREGON