




# T.16S.,R.12E.,W.M.

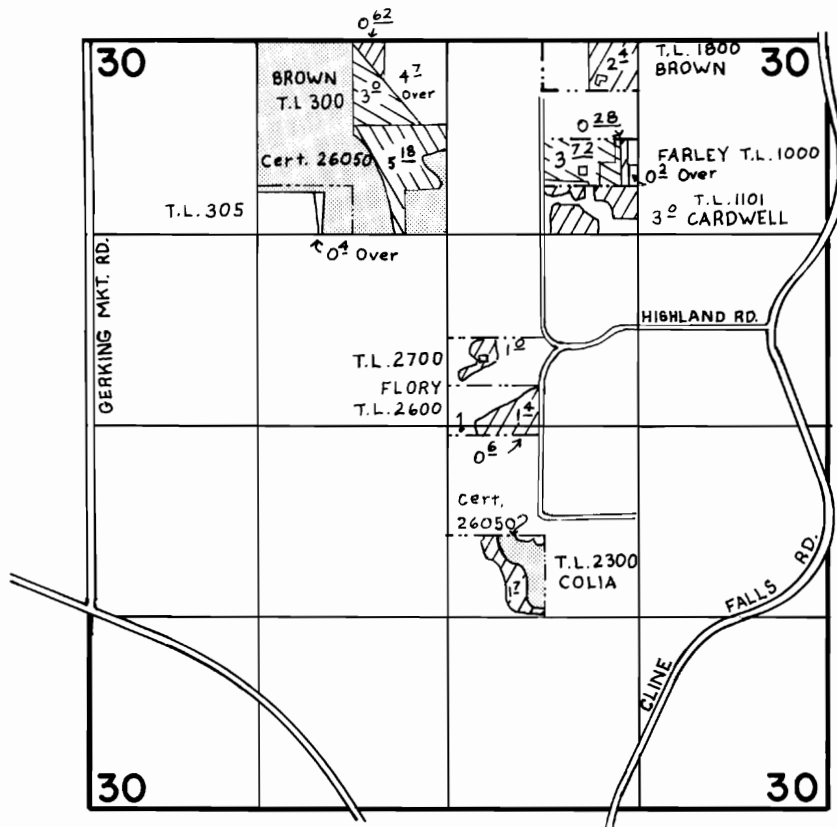


SCALE: 1" = 1320'

## FINAL PROOF SURVEY

UNDER

TRANSFERS 4143 , 4857 

AND PART OF 4964  (2/2)

IN NAME OF

**CARDWELL et. al.**

Surveyed APRIL 17, 1986., by LESLIE OLSON.....

T.I.D.  
V. 35/P. 579  
V. 31/P. 670  
V. 35/P. 232