




T. 16S., R. 12E., W.M.

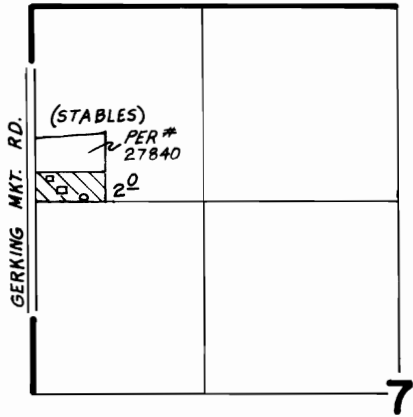

T. 16S., R. 11E., W.M.

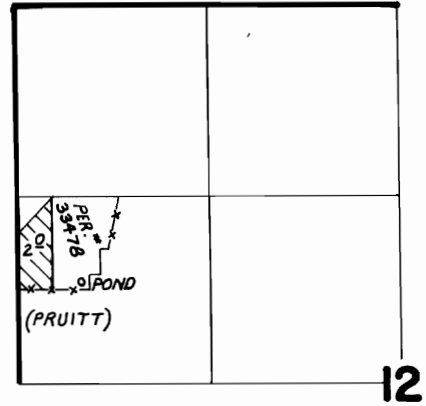

T. 16S., R. 11E., W.M.

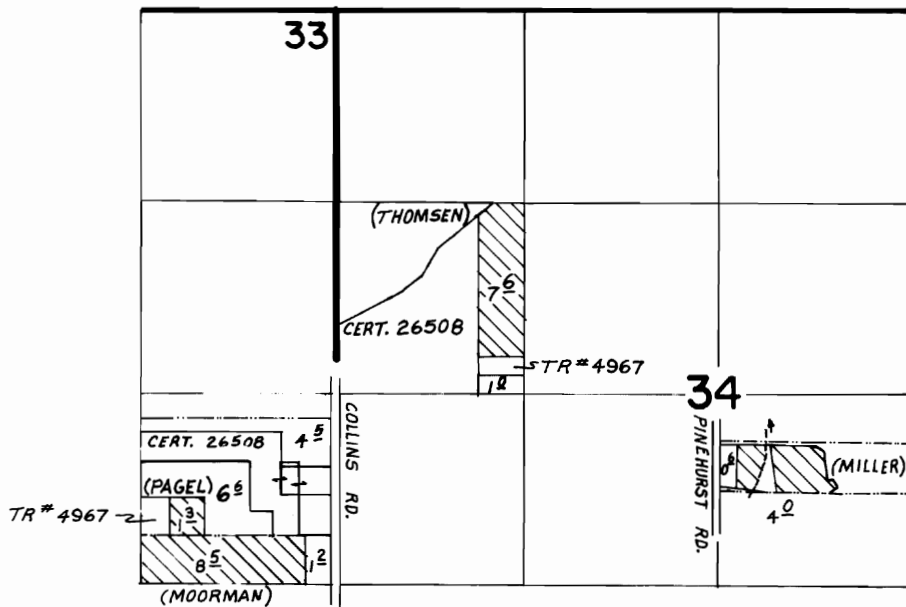

SCALE: 1" = 1320'

FINAL PROOF SURVEY

UNDER

TRANSFER NO. 4858

Application No. Permit No.
IN NAME OF

.....**T.L.D.** / as shown above.....

Surveyed AUG. 19... 1984., by LESLIE OLSON....