


T. 13S., R. 27E., W.M.

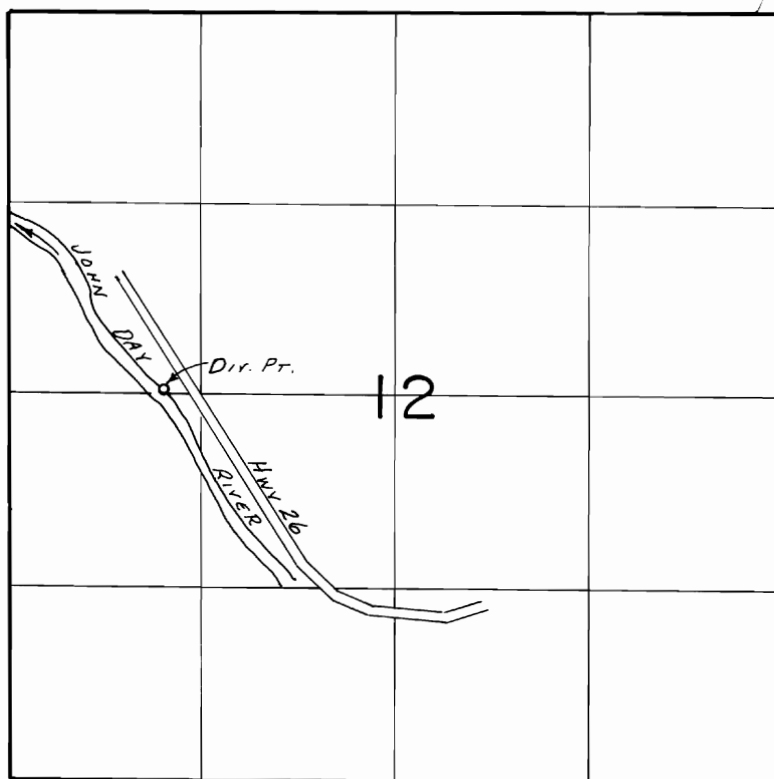

Dir. Pt. Loc.: 30' N. & 1060' E. FROM W 1/4 COR. SEC. 12.

SCALE: 1" = 1320'

# FINAL PROOF SURVEY UNDER

Transfer No. 4861

IN NAME OF

FREDERICK K. ROBERTSON

Surveyed Aug. 9.... 19.84, by J.P. PAGTER.....