


T. 28 S., R. 15 E., W.M.

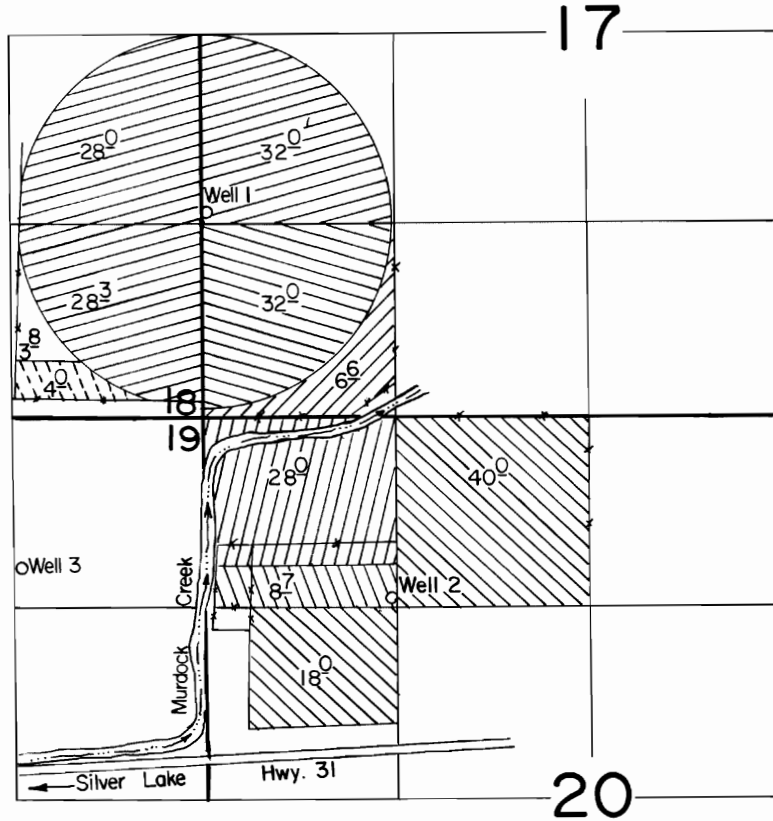

Well 1 Loc.: 1400' N. & 20' E.
 Well 2 Loc.: 1250' S. & 1290' E.
 Well 3 Loc.: 1040' S. & 1250' W. ; all from NW Cor. Sec. 20.

Scale: 1" = 1320'

FINAL PROOF SURVEY

UNDER

G-10411
 G-10384

Application No. G-11196... Permit No. G-10330...

IN NAME OF

LAWRENCE & MARJORIE IVERSON

Surveyed Sept. 16... 1985., by T. Warren.....

Primary Supp.

T- 4868		
T- 4869		
G- 9599		
G- 9463		
G- 10330		