


T.24S., R.7 W., W.M.

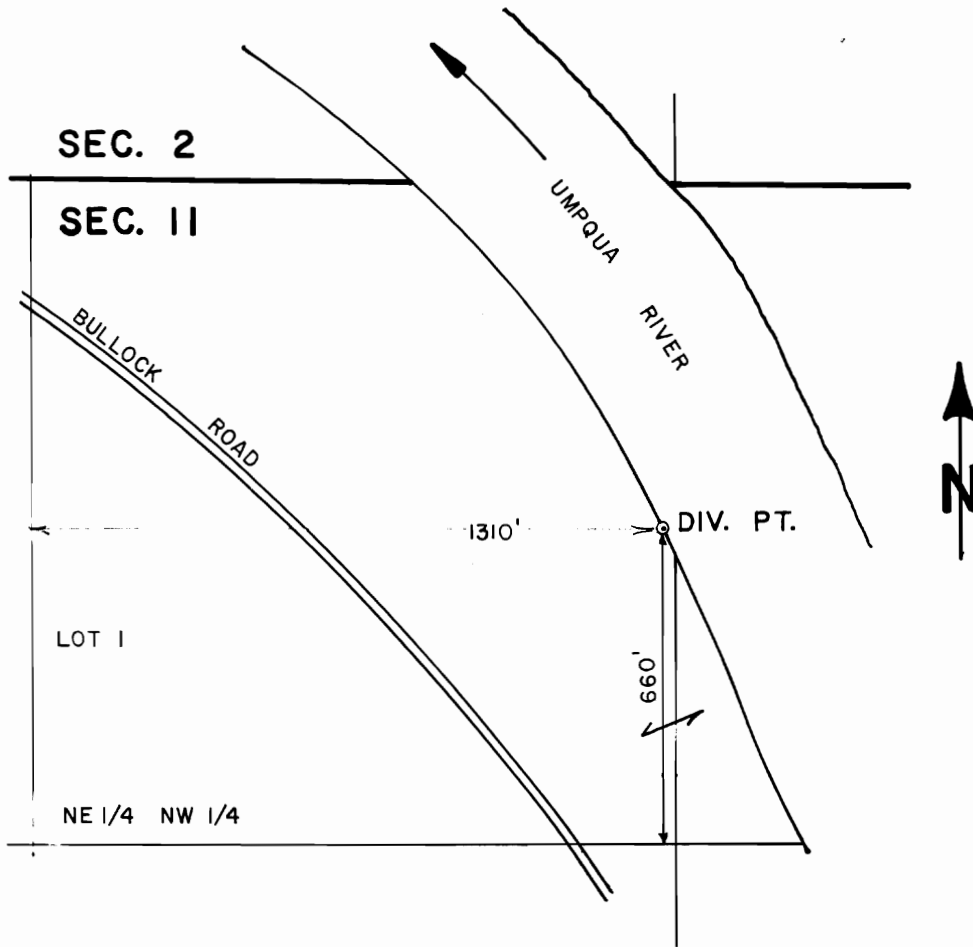

SCALE: 1" = 400'

FINAL PROOF SURVEY UNDER

TRANSFER NO. 4870

IN NAME OF

EDWARD A. WHITE

Surveyed AUG. 20, 1986, by J. M. SCHMORDE