


T. 28S., R. 6W., W.M.

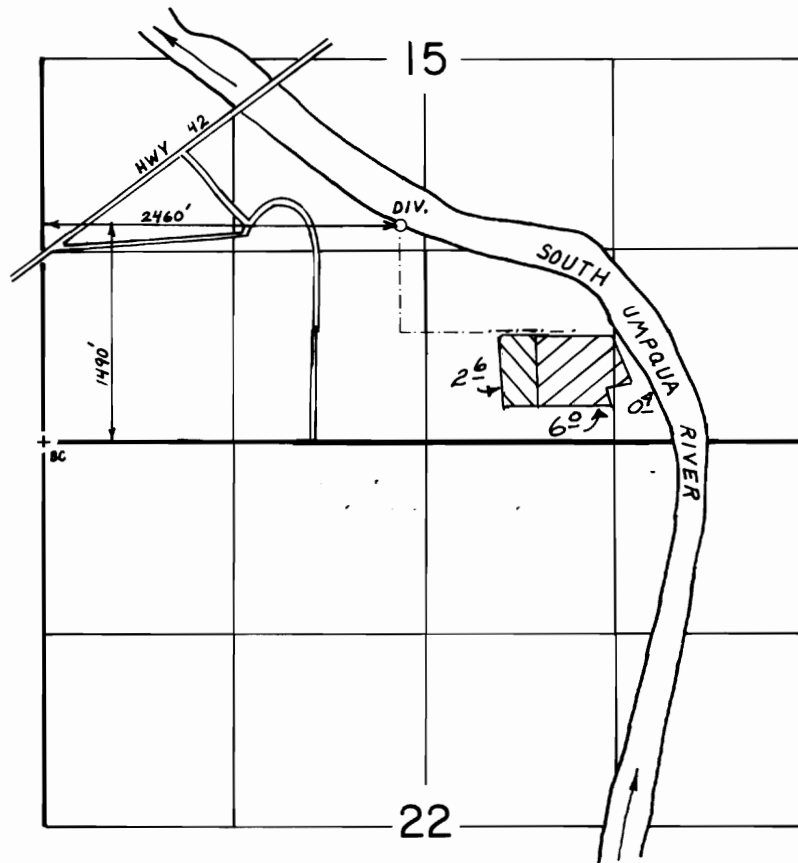


SCALE: 4" = 1 mile

FINAL PROOF SURVEY
UNDER

Application No. Permit No. T-4877
T-4878... 
IN NAME OF

.....GEORGE L. BROSI.....

Surveyed SEPT...27 19.84, by L.E. Cashion.....

REVISED 8/31/98 
BTR-IHH-113 LEC